

LINCOLN  
H46  
12-1-70

MISSISSIPPI  
BOARD OF WATER COMMISSIONERS  
416 North State Street  
Jackson, Mississippi 39201

**CODED**

**WATER WELL DRILLERS LOG**

Dec. 1 1971 71 Green Water Well Contractor Lincoln  
date well completed firm name county well located

LANDOWNER:	description of formations encountered	from	to
William Furlow	Citronelle	0	180
Old Wesson Rd., Brookhaven, Miss. (mailing address)			
<b>WELL LOCATION:</b>			
sec. 8 T. 7 N R. 8 E 1/4 miles N of Brookhaven (distance) (direction) (nearest town)			
<b>WELL PURPOSE:</b> home (home, irrigation, municipal, industrial)			
<b>WELL COMPLETION DATA:</b>			
(1) diameter (inches) 6			
(2) total depth (feet) 180			
(3) static water level (feet) 45 below top of ground.			
(4) casing PVC 158 (material) (depth) 4" if telescope see back. (size)			
(5) screen 4' 158 (length) (depth to top) .010 PVC (size) (material)			
(6) pump 1/2 Sub. 7 (HP) (yield gpm) electric (type power)			
(7) electric log no (yes or no)  (organization running log)			
(8) how well bottom plugged wood			
<b>DRILLERS REMARKS:</b>			


**CODED**

JAN 13 1971

MISS. BD. OF  
WATER COMMISSIONERS

If well telescopes please sketch and show depths.

GROUND LEVEL

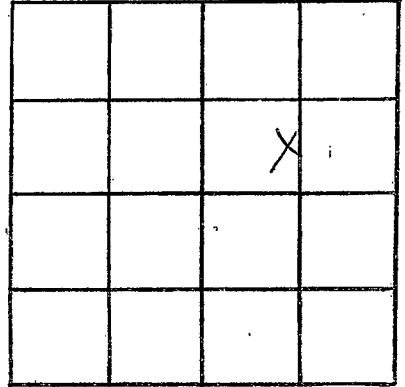

SECTION 8

Please indicate well location X.

ADDITIONAL INFORMATION

If more than one screen, show locations of each on sketch.