

OH47

4899
4968

CODED

WATER WELL DRILLERS LOG

Date: 8/8/1964, Driller: Roy Chaudler, Jr., County: Lincoln
(Name)

- (1) Owner of Land: Si Parkman
(Name)
Brookhaven Miss
(Address)
- (2) Location: 30 1/2 Sec. 7 8
4 miles South of 51
(distance) (direction) (Nearest Town)
Brookhaven
- (3) Topography: (Hilly) (Flat) (Level)
- (4) Purpose of Well: Low house
(Domestic Irrigation
Municipal, Industrial, Other)


Description & Color of Materials Sand, Clay, Red Clay, Shell, etc.	Thick- ness Feet	Depth Feet
<u>yellow clay</u>	<u>3</u>	<u>3</u>
<u>yellow sand</u>	<u>16</u>	<u>16</u>
<u>white sand & gravel</u>	<u>11</u>	<u>11</u>

Information upon completion of well:

- (1) Diameter: 8 inches.
- (2) Total Depth: 30 feet.
- (3) Water Level: 18 feet below top of ground.
- (4) Cased to: 30, Size: 8"
- (5) Screen: Size: None, Length: _____
- (6) Were any formations sealed against pollution?
all joints shall not
yes, no
concrete slab around
If YES depth of formation: well
Why: Sanitation
Drillers Remarks: Plenty water

CODED

Cannot locate exact loc.
Not worth estimate of loc.
RA

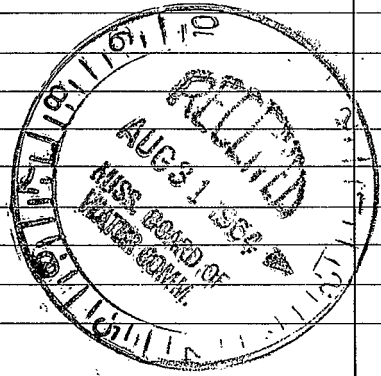

(Use Back Side)

Well No.

100

100

