

LINCOLN
H 49
10-12-71

MISSISSIPPI
 BOARD OF WATER COMMISSIONERS
 416 North State Street
 Jackson, Mississippi 39201

DEC 28 1971

MISS. BD. OF

CODED

WATER WELL DRILLERS LOG

Lincoln
 county well located

Oct 17 19 *71* *Chester Keener*
 date well completed firm name

LANDOWNER: *Jerry Lucas*
Brookhaven Miss

description of formations encountered	from	to
<i>Red clay</i>	<i>0</i>	<i>12</i>
<i>Red sand</i>	<i>12</i>	<i>40</i>
<i>Gravel sand</i>	<i>40</i>	<i>48</i>

(mailing address)

WELL LOCATION:
 sec. *24* T. *7* N. R. *8* E
2 miles *SE* *Brookhaven*
 (distance) (direction) (nearest town)

WELL PURPOSE: *Home*
 (home, irrigation, municipal, industrial)

WELL COMPLETION DATA:

- (1) diameter (inches) *2 1/2"*
- (2) total depth (feet) *48'*
- (3) static water level (feet) *36* below above top of ground.
- (4) casing *Plast. galv.*
 (material) (depth)
- (size) if telescope see back.
- (5) screen *6'* *42'*
 (length) (depth to top)
- 4"* *Plast.*
 (size) (material)
- (6) pump *Boyer*
 (HP) (yield/gpm)
- (type power)
- (7) electric log *NO*
 (yes or no)

CODED


(organization running log)

(8) how well bottom plugged
wooden plug

DRILLERS REMARKS:
New house.

If well telescopes please sketch and show depths.

GROUND LEVEL

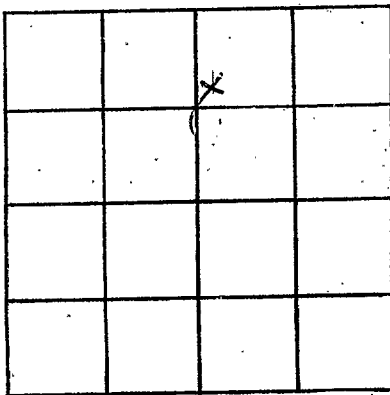

SECTION 24

Please indicate well location X.

ADDITIONAL INFORMATION

If more than one screen, show locations of each on sketch.