

**LINCOLN**  
**H50**  
**4-14-72**

MISSISSIPPI  
 BOARD OF WATER COMMISSIONERS  
 416 North State Street  
 Jackson, Mississippi 39201  
**WATER WELL DRILLERS LOG**

**CODED**

April 14 1972 Green W. Const. Lincoln  
 date well completed firm name county well located

LANDOWNER: <u>Levyne Wilson</u>	description of formations encountered	from	to
	<u>Red sand &amp; gravel</u>	<u>0</u>	<u>40</u>
	<u>white Clay</u>	<u>40</u>	<u>85</u>
<u>Brookhaven Miss</u> (mailing address)	<u>Red sand</u>	<u>85</u>	<u>128</u>
	<u>yellow Clay</u>	<u>128</u>	<u>120</u>
<b>WELL LOCATION:</b>			
sec. <u>11</u> T. <u>7</u> N. R. <u>8</u> E.			
<u>2</u> miles <u>W</u> of <u>Brookhaven</u> (distance) (direction) (nearest town)			
<b>WELL PURPOSE:</b> <u>Home</u> (home, irrigation, municipal, industrial)			
<b>WELL COMPLETION DATA:</b>			
(1) diameter (inches) <u>6"</u>			
(2) total depth (feet) <u>140</u>			
(3) static water level (feet) <u>40</u> below above top of ground.			
(4) casing <u>PVC</u> , <u>120</u> , (material) (depth) <u>4"</u> if telescope see back. (size)			
(5) screen <u>6'</u> , <u>120</u> (length) (depth to top) <u>010</u> , <u>PVC</u> (size) (material)			
(6) pump <u>1/3 sub</u> , <u>7</u> (HP) (yield gpm) <u>Electric</u> (type power)			
(7) electric log <u>no</u> (yes or no)			
(organization running log)			
(8) how well bottom plugged <u>wood</u>			
<b>DRILLERS REMARKS:</b>			


**CODED**

JUN 12 1972

MISSISSIPPI  
 BOARD OF WATER COMMISSIONERS

If well telescopes please sketch and show depths.

GROUND LEVEL

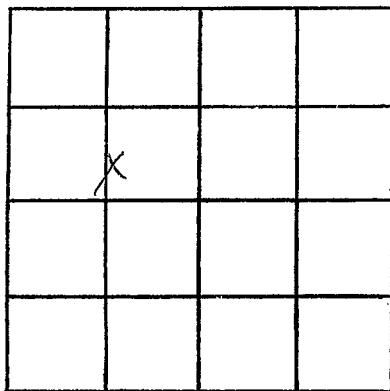

SECTION 11

Please indicate well location X.

ADDITIONAL INFORMATION

A series of horizontal lines for writing additional information.

If more than one screen, show locations of each on sketch.