

LINCOLN  
H51  
2-11-72

MISSISSIPPI  
BOARD OF WATER COMMISSIONERS  
416 North State Street  
Jackson, Mississippi 39201

**CODED**

WATER WELL DRILLERS LOG

Feb-11 1972 *Chester Keene* *Lincoln*  
date well completed firm name county well located

LANDOWNER: *R. L. Foster -*

*RFD,*  
*Brookhaven, Miss*  
(mailing address)

WELL LOCATION:

sec. *24* T. *7* N. R. *5* E  
*5* miles *E* of *Brookhaven*  
(distance) (direction) (nearest town)

WELL PURPOSE: *Home*  
(home, irrigation, municipal, industrial)

WELL COMPLETION DATA:

- (1) diameter (inches) *4"*
- (2) total depth (feet) *114*
- (3) static water level (feet) *60* below top of ground
- (4) casing *Plast bottom*  
(material) (depth)
- (size) If telescope see back.
- (5) screen *6'* *104'*  
(length) (depth to top)  
*1"* *Plast*  
(size) (material)
- (6) pump *old pump*  
(HP) (yield gpm)  
*Plast*  
(type power)
- (7) electric log *no*  
(yes or no)

(organization running log)

(8) how well bottom plugged  
*no plug*

DRILLERS REMARKS:  
*old well had*

description of formations encountered

from to

<i>clay &amp; gravel</i>	<i>0</i>	<i>12</i>
<i>2" gravel &amp; sand</i>	<i>12</i>	<i>24</i>
<i>pink loess</i>	<i>24</i>	<i>32</i>
<i>red to chalk</i>	<i>32</i>	<i>93</i>
<i>white fine sand</i>	<i>93</i>	<i>105</i>
<i>coarse sand</i>	<i>105</i>	<i>114</i>


*This well had to have 6" screen casing to check at 32 ft. The big gravel above could not be sealed to prevent casing and filling holes below*

**CODED**

JUN 29 1972

If well telescopes please sketch and show depths.

GROUND LEVEL

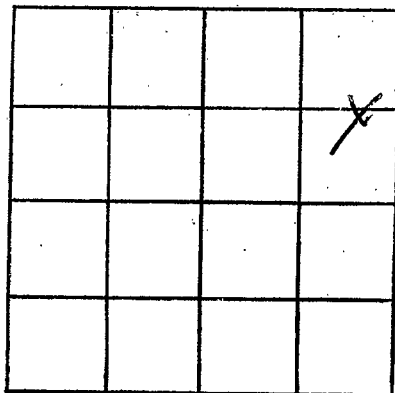

SECTION 24

Please indicate well location X.

ADDITIONAL INFORMATION

If more than one screen,  
show locations of each on sketch.