

LINCOLN
H52
5-24-72

MISSISSIPPI
BOARD OF WATER COMMISSIONERS
416 North State Street
Jackson, Mississippi 39201

WATER WELL DRILLERS LOG

CODED

May 24 1972 Gretn Water Well Contr. Lincoln
date well completed firm name county well located


LANDOWNER:	description of formations encountered	from	to
Louella Markham Brignal Rd. Brookhaven, Miss. (mailing address)			
WELL LOCATION:			
sec. 31 T 7 N R 8 E 1 miles N of Brookhaven (distance) (direction) (nearest town)			
WELL PURPOSE: home (home, irrigation, municipal, industrial)			
WELL COMPLETION DATA:			
(1) diameter (inches) 6"			
(2) total depth (feet) 120			
(3) static water level (feet) 60 below top of ground.			
(4) casing PVC 94 (material) (depth) 4" if telescope see back. (size)			
(5) screen 6' 94' (length) (depth to top) 1/2" PVC (size) (material)			
(6) pump did not install (HP) (yield gpm) (type power)			
(7) electric log no (yes or no) (organization running log)			
(8) how well bottom plugged wood			
DRILLERS REMARKS:			

CODED

APR 28 1972

If well telescopes please sketch and show depths.

GROUND LEVEL

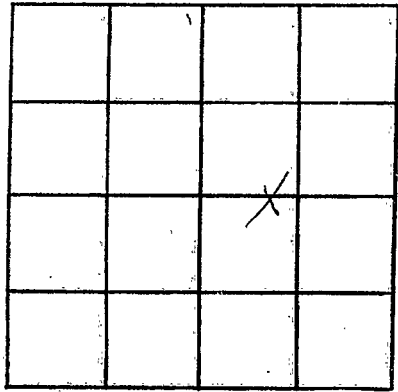

SECTION 31

Please indicate well location X.

ADDITIONAL INFORMATION

Lined area for additional information.

If more than one screen, show locations of each on sketch.