

**LINCOLN**  
**H 53**  
**5-2-72**

MISSISSIPPI  
 BOARD OF WATER COMMISSIONERS  
 416 North State Street  
 Jackson, Mississippi 39201

**CODED**

**WATER WELL DRILLERS LOG**

date well completed May 2 1972 firm name Chester Keeler county well located Lincoln

LANDOWNER: James Barnett  
P.O. Brookhaven  
 (mailing address)

description of formations encountered	from	to
Red sandy clay	0	16
Red sand & gravel	16	52
white chalk	52	91
fine sand	91	125
coarse white sand	125	139

WELL LOCATION:  
 sec. 24 T. 7 N. R. 8 E. S. 5  
5 miles E Brookhaven  
 (distance) (direction) (nearest town)

WELL PURPOSE: Home  
 (home, irrigation, municipal, industrial)

WELL COMPLETION DATA:

(1) diameter (inches) 4"

(2) total depth (feet) 139

(3) static water level (feet) 79 below top of ground

(4) casing Plast (material) Bottom (depth)

\_\_\_\_\_ if telescope see back., (size)

(5) screen 6' (length) 133' (depth to top)

4" (size) Plast (material)

(6) pump sed pump jet (HP) \_\_\_\_\_ (yield gpm)

Elect (type power)

(7) electric log no (yes or no)

\_\_\_\_\_ (organization running log)

(8) how well bottom plugged wooden plug

DRILLERS REMARKS: sed well had.


**CODED**

APR 30 1972

MISS. DIV. OF  
 WATER RESOURCES

If well telescopes please sketch and show depths.

GROUND LEVEL

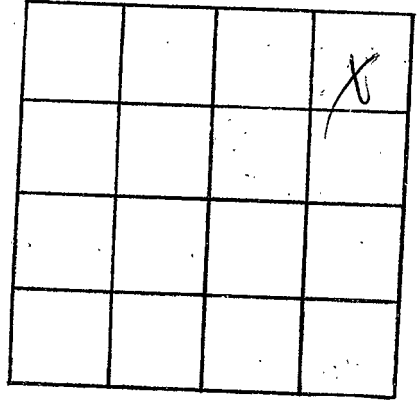

SECTION *218*

Please indicate well location X.

ADDITIONAL INFORMATION

If more than one screen, show locations of each on sketch.