

432 E. Cherokee

LINCOLN
H 55

MISSISSIPPI
BOARD OF WATER COMMISSIONERS
416 North State Street
Jackson, Mississippi 39201

Sec. 18 ?

10-2-72

WATER WELL DRILLERS LOG

date well completed

firm name

county well located

LANDOWNERS:

description of formations encountered

from

to

Brookhaven

Red clay

0 18

(mailing address)

Red sand

18 36

WELL LOCATION:

sec. *7* T. *7* N. R. *8* E

Red chert

36 62

1/4 miles *NE* of *Part Brookhaven*
(distance) (direction) (nearest town)

*chert and
loblolly sand*

62 124

WELL PURPOSE: *same*
(home, irrigation, municipal, industrial)

Sand & gravel

124 152

WELL COMPLETION DATA:

(1) diameter (inches) *4"*

(2) total depth (feet) *152*

(3) static water level (feet) *5'* below top of ground.

(4) casing *Plastic Baller*
(material) (depth)

(size) If telescope see back.

(5) screen *6'* *146'*
(length) (depth to top)

4" *plast*
(size) (material)

(6) pump *runner well pump*
(HP) (yield gpm)

elect
(type power)

(7) electric log *No*
(yes or no)

(organization running log)

(8) how well bottom plugged
wooden plug

DRILLERS REMARKS:


old 2" well head

DEC 4 1972

WATER COM

If well telescopes please sketch and show depths.

GROUND LEVEL

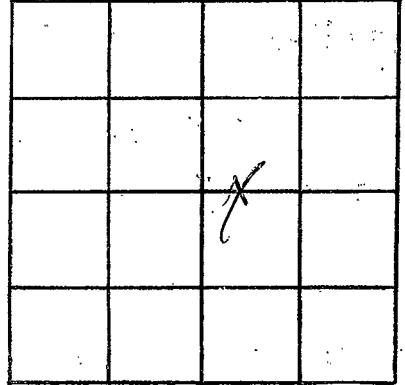

SECTION 7

Please indicate well location X.

ADDITIONAL INFORMATION

If more than one screen,
show locations of each on sketch.