

Williams E & A.

LINCOLN  
H 57  
5-2-74

MISSISSIPPI  
BOARD OF WATER COMMISSIONERS  
416 North State Street  
Jackson, Mississippi 39201

CODED

WATER WELL DRILLERS LOG

May 2

1974 Grenn Water Well Cont. Lincoln

date well completed

firm name

county well located

LANDOWNER:	description of formations encountered	from	to
Hilary Dixon Rt. 4, Box 1 Brookhaven, Mkss. (mailing address)	Citronelle	0	135
<b>WELL LOCATION:</b>			
sec. 8 T. 7 N R. 8 E 1 miles E of Brookhaven (distance) (direction) (nearest town)	CODED		
<b>WELL PURPOSE:</b> home (home, irrigation, municipal, industrial)			
<b>WELL COMPLETION DATA:</b>			
(1) diameter (inches) 6"			
(2) total depth (feet) 135'			
(3) static water level (feet) 40' below top of ground.			
(4) casing PVC, 129', 4" (material), (depth), (size) if telescope see back.			
(5) screen 6', 129' (length), (depth to top) .010, PVC (size), (material)			
(6) pump 1/3 sub 7 (HP), (yield gpm) electric (type power)			
(7) electric log no (yes or no)			
(8) how well bottom plugged wood			


DRILLERS REMARKS: ALLEN 7-1-1974

DRILLERS REMARKS:

MISS. Bd. OF WATER COMMISSIONERS

If well telescopes please sketch and show depths.

GROUND LEVEL

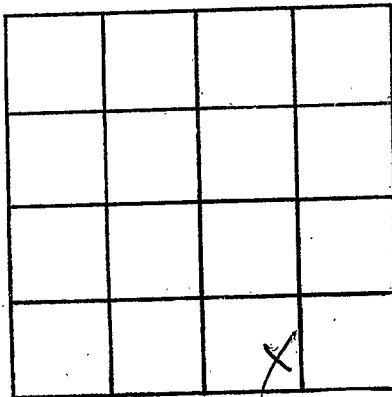

SECTION 8

Please indicate well location X.

ADDITIONAL INFORMATION

If more than one screen,  
show locations of each on sketch.