

LINCOLN
H 59
4.2-75

MISSISSIPPI
 BOARD OF WATER COMMISSIONERS
 416 North State Street
 Jackson, Mississippi 39201

CODED

WATER WELL DRILLERS LOG

April 2 1975 Grenn Water Well Cont., Lincoln
 date well completed firm name county well located


LANDOWNER: <u>Harold Warren</u> <u>Lakewood Village</u>	description of fomations encountered	from	to
<u>Brookhaven, Miss.</u> (mailing address)	<u>Citronelle</u>	<u>1</u>	<u>105</u>
WELL LOCATION:			
sec. <u>30</u> T. <u>7</u> N. R. <u>8</u> E. <u>3</u> <u>3</u> <u>W</u> <u>2</u> miles <u>SE</u> of <u>Brookhaven</u> (distance) (direction) (nearest town)			
WELL PURPOSE: <u>home</u> (home, irrigation, municipal, industrial)			
WELL COMPLETION DATA:			
(1) diameter (inches) <u>6"</u>			
(2) total depth (feet) <u>105</u>			
(3) static water level (feet) <u>18</u> below top of ground.			
(4) casing <u>PVC</u> , <u>99'</u> (material) (depth) <u>4"</u> (size) If telescope see back.			
(5) screen <u>6'</u> , <u>99'</u> (length) (depth to top)			
<u>.010</u> , <u>PVC</u> (size) (material)			
(6) pump <u>did not install</u> (HP) (yield gpm) (type power)			
(7) electric log <u>no</u> (yes or no) (organization running log)			
(8) how well bottom plugged <u>wood</u>			
DRILLERS REMARKS:			

RECEIVED
 MAY 9 1975

MISS. BD. OF WATER COMM.

If well telescopes please sketch and show depths.

GROUND LEVEL

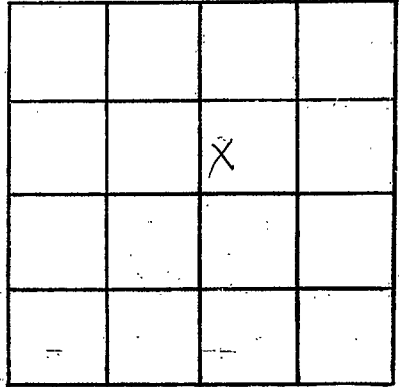

SECTION 30

Please indicate well location X.

ADDITIONAL INFORMATION

If more than one screen, show locations of each on sketch.