

625 E. Cherokee

Sec. 18

LINCOLN
#60
4-4-75

MISSISSIPPI
BOARD OF WATER COMMISSIONERS
416 North State Street
Jackson, Mississippi 39201

CODED

WATER WELL DRILLERS LOG

April 4

1975 Grenn Water Well Cont.

Lincoln

date well completed

firm name

county well located

LANDOWNER: Cliff Givens

Route 4

Brookhaven, Miss.

(mailing address)

description of formations
encountered

from

to

Citronelle

1

86

WELL LOCATION:

sec. 8 T. 7 N. R. 8 E.
-S- -W-

1 miles E of Brookhaven
(distance) (direction) (nearest town)

WELL PURPOSE: home
(home, irrigation, municipal, industrial)

WELL COMPLETION DATA:

- (1) diameter (inches) 6"
- (2) total depth (feet) 86
- (3) static water level (feet) 50 below
top of ground. above

(4) casing PVC, 80'
(material) (depth)
4"
(size) if telescope see back.

(5) screen 6", 80'
(length) (depth to top)
.010, PVC
(size) (material)

(6) pump 1/3 Sub 7
(HP) (yield gpm)
electricity
(type power)

(7) electric log no
(yes or no)

(organization running log)

(8) how well bottom plugged wood

DRILLERS REMARKS:


RECEIVED

MAY - 9 1975

MISS. BD. OF WATER COMMISSIONERS

If well telescopes please sketch and show depths.

GROUND LEVEL

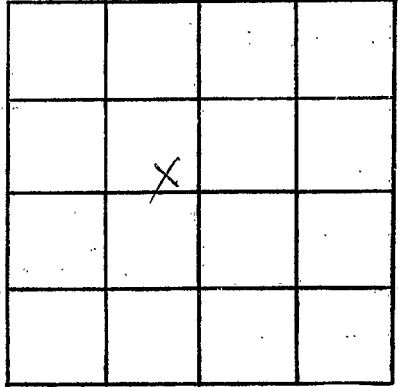

SECTION 8

Please indicate well location X.

ADDITIONAL INFORMATION

If more than one screen, show locations of each on sketch.