


①

If well telescopes please sketch and show depths.

GROUND LEVEL

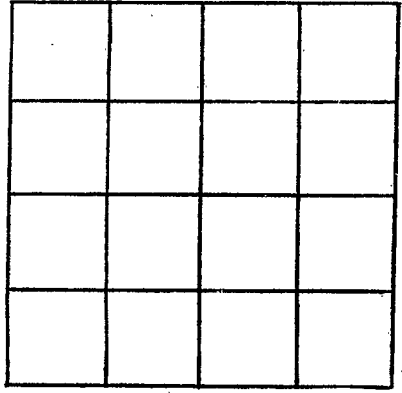

SECTION _____

Please indicate well location X.

ADDITIONAL INFORMATION

A series of 20 horizontal lines for entering additional information.

If more than one screen, show locations of each on sketch.