

LINCOLN
H63

**MISSISSIPPI DEPARTMENT OF NATURAL RESOURCES**  
 Bureau of Land and Water Resources  
 Southport Mall  
 P.O. Box 10631  
 Jackson, Mississippi 39209  
**WATER WELL DRILLERS LOG**

CODED

11-26-1984  
 date well completed

Grenn Water Well  
 firm name

Lincoln  
 county well located

LANDOWNER: Alvin J. Brown

description of formations encountered

from to

Route 4

Citronelle

1 98

Brookhaven, Ms.  
 (mailing address)

**WELL LOCATION:**

sec. 36 T-7 N R-8 E  
 6 miles SE of Brookhaven  
 (distance) (direction) (nearest town)

WELL PURPOSE: home  
 (home, irrigation, municipal, industrial)

**WELL COMPLETION DATA:**

- (1) diameter (inches) 4
- (2) total depth (feet) 98
- (3) static water level (feet) 65 below above top of ground.
- (4) casing PVC 88'  
 (material) (depth)  
 4" if telescope see back.  
 (size)
- (5) screen 10' 88'  
 (length) (depth to top)  
 .010 PVC  
 (size) (material)
- (6) pump did not install  
 (HP) (yield gpm)  
 (type power)
- (7) electric log no  
 (yes or no)  
 (organization running log)

(8) how well bottom plugged  
 back wash valve

DRILLERS REMARKS:

CODED


**RECEIVED**

APR 16 1985

Department of Natural Resources  
 Bureau of Land & Water Resources

If well telescopes please sketch and show depths.

GROUND LEVEL

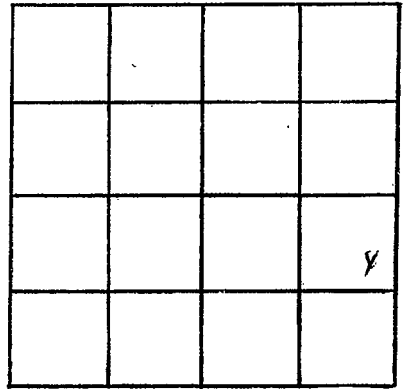

SECTION 6

Please indicate well location X.

ADDITIONAL INFORMATION

If more than one screen,  
show locations of each on sketch.