

LINCOLN
F 42 H 68

MISSISSIPPI DEPARTMENT OF NATURAL RESOURCES
Bureau of Land and Water Resources
Southport Mall
P.O. Box 10631
Jackson, Mississippi 39209
WATER WELL DRILLERS LOG

CODED

Oct. 24 1985 Grenn Water Well Lincoln
date well completed firm name county well located

LANDOWNER:	description of formations encountered	from	to
Clark Arrington	Citronelle	1	125
583 South Brookhaven, Ms. (mailing address)			
CODED			
WELL LOCATION:			
sec. 29 T 7 N S R 8 E W			
1 miles S of Brookhaven (distance) (direction) (nearest town)			
WELL PURPOSE: shop (home, irrigation, municipal, industrial)			
WELL COMPLETION DATA:			
(1) diameter (inches) 4			
(2) total depth (feet) 125			
(3) static water level (feet) 55 below above top of ground.			
(4) casing PVC 115 (material) (depth) 4" if telescope see back. (size)			
(5) screen 10' 115' (length) (depth to top) .010 PVC (size) (material)			
(6) pump 1/2 sub 10 ± (HP) (yield gpm) electricity (type power)			
(7) electric log no (yes or no) (organization running log)			
(8) how well bottom plugged back wash valve			

RECEIVED


APR 17 1985

DRILLERS REMARKS:

Department of Natural Resources
Bureau of Land & Water Resources

If well telescopes please sketch and show depths.

GROUND LEVEL

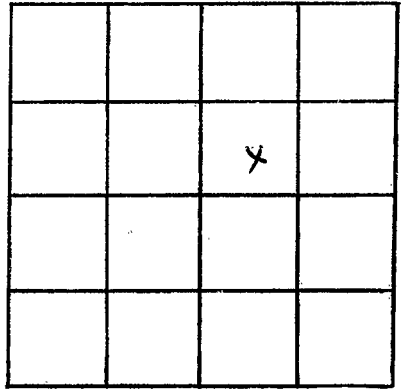

SECTION 29

Please indicate well location X.

ADDITIONAL INFORMATION

If more than one screen,
show locations of each on sketch.