

LINCOLN

H 69

MISSISSIPPI DEPARTMENT OF NATURAL RESOURCES  
 Bureau of Land and Water Resources  
 Southport Mall  
 P.O. Box 10631  
 Jackson, Mississippi 39209  
**WATER WELL DRILLERS LOG**

CODED

Oct 19 1984  
date well completed

Gretn Water Well  
firm name

Lincoln  
county well located

LANDOWNER: Billy Nash

description of formations encountered

from 1 to 115

109 Fisher St.

Citronelle

Brookhaven, Miss.  
(mailing address)

WELL LOCATION:

sec. 30 T 7 N R 8 E  
 S W  
 1 miles S of Brookhaven  
 (distance) (direction) (nearest town)

CODED

WELL PURPOSE: home  
(home, irrigation, municipal, industrial)

WELL COMPLETION DATA:

- (1) diameter (inches) 4
- (2) total depth (feet) 115
- (3) static water level (feet) 25 below above top of ground.
- (4) casing PVC 105  
(material) (depth)  
4" if telescope see back.  
(size)
- (5) screen 10' 105'  
(length) (depth to top)  
.010 PVC  
(size) (material)
- (6) pump 1/2 sub 10  
(HP) (yield gpm)  
electricity  
(type power)
- (7) electric log no  
(yes or no)  
(organization running log)

RECEIVED

APR 17 1985


(8) how well bottom plugged back wash valve

Department of Natural Resources  
Bureau of Land & Water Resources

DRILLERS REMARKS:

If well telescopes please sketch and show depths.

GROUND LEVEL

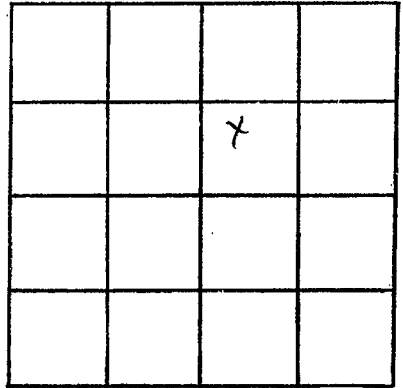

SECTION 30

Please indicate well location X.

ADDITIONAL INFORMATION

If more than one screen,  
show locations of each on sketch.