

Lincoln
A70
4-28-86

MISSISSIPPI DEPARTMENT OF NATURAL RESOURCES
Bureau of Land and Water Resources
Southport Mall
P.O. Box 10631
Jackson, Mississippi 39209 **CODED**
WATER WELL DRILLERS LOG

4/28 1986 Jerry Guinn Waterwell Serv. Lincoln
date well completed firm name county well located

LANDOWNER: LeRoy Cartwright

description of formations encountered

from to

Rt. 5

~~Red Clay~~
Sand & Gravel

0 10
10 80

Brookhaven, Ms 39601
(mailing address)

WELL LOCATION:


sec. 30 T 7 N R 8 E
2 miles SE of Brookhaven
(distance) (direction) (nearest town)

CODED

WELL PURPOSE: None
(home, irrigation, municipal, industrial)

WELL COMPLETION DATA:

- (1) diameter (inches) 4"
- (2) total depth (feet) 80'
- (3) static water level (feet) 54' below above top of ground.
- (4) casing PVC, 80'
(material) (depth)
4" if telescope see back.
(size)
- (5) screen 10', 70'
(length) (depth to top)
4", PVC
(size) (material)
- (6) pump 1/2, 10
(HP) (yield gpm)
Electricity
(type power)
- (7) electric log Yes
(yes or no)
Ms. Geological Survey
(organization running log)
- (8) how well bottom plugged Backwash
valve

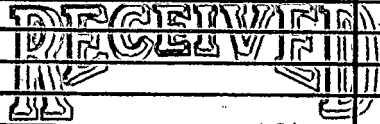


JUN 10 1986

Department of Natural Resources
Bureau of Land & Water Resources

DRILLERS REMARKS:

If well telescopes please sketch and show depths.

GROUND LEVEL

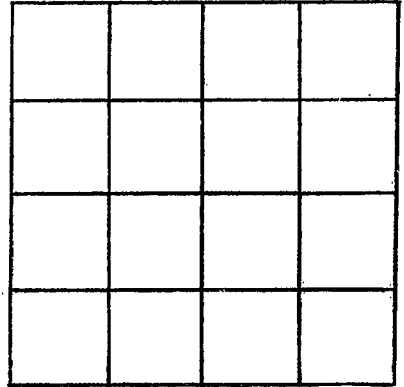

SECTION _____

Please indicate well location X.

ADDITIONAL INFORMATION

If more than one screen,
show locations of each on sketch.