

LINCOLN  
H 71  
10-30-86

MISSISSIPPI DEPARTMENT OF NATURAL RESOURCES  
Bureau of Land and Water Resources  
Southport Mall  
P.O. Box 10631  
Jackson, Mississippi 39209  
WATER WELL DRILLERS LOG

CODED

10/30 1986 Jerry Quinn Water Well Serv  
date well completed firm name county well located Lincoln

LANDOWNER: C & M Milling Co  
Old Hwy 51 S  
Brookhaven, Ms  
(mailing address)

description of formations encountered	from	to
Clay	0	150
Sand	150	160

WELL LOCATION:  
sec. 1 T 7 N R 8 E  
1/2 miles S of Brookhaven  
(distance) (direction) (nearest town)

WELL PURPOSE: Industrial  
(home, irrigation, municipal, industrial)

- WELL COMPLETION DATA:
- (1) diameter (inches) 4"
  - (2) total depth (feet) 160'
  - (3) static water level (feet) 62 below above top of ground.
  - (4) casing PVC, 150' (material) (depth)  
4" (size) if telescope see back.
  - (5) screen 10' 150' (length) (depth to top)  
4" (size) PVC (material)
  - (6) pump 1 10 (HP) (yield gpm)  
electricity (type power)
  - (7) electric log ~~Yes~~ No (yes or no)  
~~Brookhaven Laboratory~~ (organization running log)
  - (8) how well bottom plugged Backwash Valve

CODED

RECEIVED


NOV 19 1986

Department of Natural Resources  
Bureau of Land & Water Resources

DRILLERS REMARKS:

If well telescopes please sketch and show depths.

GROUND LEVEL

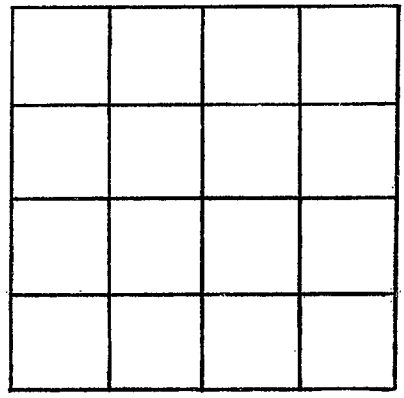

SECTION \_\_\_\_\_

Please indicate well location X.

ADDITIONAL INFORMATION

A series of horizontal lines for entering additional information, located below the 'ADDITIONAL INFORMATION' header.

If more than one screen, show locations of each on sketch.