

MISSISSIPPI DEPARTMENT OF NATURAL RESOURCES

Bureau of Land and Water Resources

Southport Mall

P.O. Box 10631

Jackson, Mississippi 39209

WATER WELL DRILLERS LOG

Lincoln  
H 73  
10-16-87

October 16, 19 87 Layne-Central Co. Lincoln  
 date well completed firm name county well located

LANDOWNER:	description of formations encountered	from	to
description of formations encountered			
<u>Lincoln Rural Water Assoc.</u>	<u>Yellow Clay</u>	<u>0'</u>	<u>20'</u>
<u>P.O. Box 404</u>	<u>Red White Sand + Gravel</u>	<u>20'</u>	<u>175'</u>
<u>BROOKHAVEN, MISS. 39601</u> (mailing address)	<u>Clay + Gravel</u>	<u>175'</u>	<u>210'</u>
<u>WELL LOCATION: SE 1/4 Q NE 1/4</u>	<u>Blue Clay (SOFT)</u>	<u>210'</u>	<u>328'</u>
sec. <u>6</u> T. <u>7</u> N. <u>5</u> R. <u>8</u> E. <u>#</u>	<u>Sandy Clay</u>	<u>328'</u>	<u>358'</u>
<u>miles</u> of (distance) (direction) (nearest town)	<u>Blue Clay (HARD)</u>	<u>358'</u>	<u>368'</u>
<u>WELL PURPOSE: DOMESTIC</u> (home, irrigation, municipal, industrial)	<u>SAND (HARD) Clay streaks</u>	<u>368'</u>	<u>426'</u>
<u>WELL COMPLETION DATA:</u>	<u>HARD CLAY</u>	<u>426'</u>	<u>432'</u>
(1) diameter (inches) <u>12"</u>	<u>SANDY CLAY</u>	<u>432'</u>	<u>492'</u>
(2) total depth (feet) <u>809'-4"</u>	<u>LIMESTONE</u>	<u>492'</u>	<u>495'</u>
(3) static water level (feet) <u>312'</u> below above top of ground.	<u>HARD CLAY + SAND STKS.</u>	<u>495'</u>	<u>700'</u>
(4) casing <u>Steel</u> (material) <u>712.5'</u> (depth)	<u>SANDY CLAY</u>	<u>700'</u>	<u>782'</u>
<u>12"</u> (size) <u>60'</u> of <u>8"</u> If telescope see back.	<u>SAND</u>	<u>782'</u>	<u>814'</u>
(5) screen <u>35'</u> (length) <u>809'-4"</u> (depth to top)	<u>SAND + CLAY STREAKS</u>	<u>814'</u>	<u>951'</u>
<u>8"</u> (size) <u>Stainless Steel</u> (material)	<u>HARD CLAY + SAND STKS.</u>	<u>951'</u>	<u>1136'</u>
(6) pump <u>40</u> (HP) <u>300 GPM</u> (yield gpm)			
<u>480 volts</u> (type power)			
(7) electric log <u>Yes</u> (yes or no)			
<u>Layne-Central Co.</u> (organization running log)			
(8) how well bottom plugged <u>Back Pressure Valve</u>			
DRILLERS REMARKS: <u>Permit No. GW6620</u>			


RECEIVED

JUN 28 1988

Department of Natural Resources  
 Bureau of Land & Water Resources

If well telescopes please sketch and show depths.

GROUND LEVEL

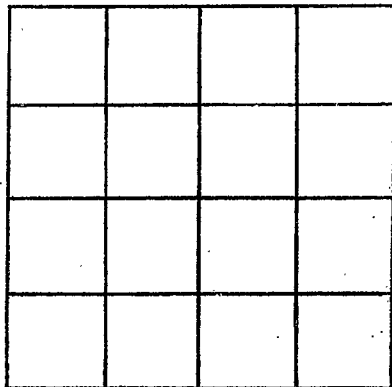

SECTION \_\_\_\_\_

Please indicate well location X.

ADDITIONAL INFORMATION

If more than one screen,  
show locations of each on sketch.