

test well

MISSISSIPPI DEPARTMENT OF ENVIRONMENTAL QUALITY

Office of Land and Water Resources

P. O. Box 10631
Jackson, MS 39289-0631
WATER WELL DRILLERS LOG

COUNTY WELL LOCATED
Lincoln
WELL NUMBER
H77
CODED
DATE WELL COMPLETED
06-07-94

PERMIT NUMBER
NAME OF DRILLING FIRM
Griner Drilling
Service, Inc.

NAME & MAILING ADDRESS OF LANDOWNER
Topisaw Creek Water Assn.
1967 Mallilieu Dr., S.E.
Ruth, MS 39662
WELL LOCATION: SEC TOWNSHIP RANGE
29 7 [N] 8 [E]
DISTANCE DIRECTION NEAREST TOWN
2 Miles East of Brookhaven
OTHER LANDMARK
Near intersection of 84 & 583
WELL PURPOSE: Home, Irrigation, Municipal, Industrial, Fish Pond, etc.
Test

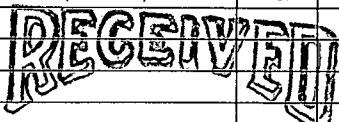
PUMP DATA
PUMP TYPE (Circle One):
<input checked="" type="checkbox"/> Submersible, <input type="checkbox"/> Turbine, <input type="checkbox"/> Jet <input type="checkbox"/> Flowing Well,
Other (Describe) _____
POWER TYPE (Circle One):
<input checked="" type="checkbox"/> Electric, <input type="checkbox"/> Tractor, <input type="checkbox"/> Diesel, <input type="checkbox"/> Gasoline, <input type="checkbox"/> Butane,
Other (Describe) _____ H/P 7.5
Pump Capacity (GPM) No. of Stages Setting Depth
120 5 189 FT.
PUMP TEST
Well yielded 90 GPM with
a drawdown of 30.60 ft.
after 4 hours of pumping

WELL DATA
Well Depth Casing Diameter (In.) Casing Length (Ft.)
215 4 195
Type of Casing Hole Depth Depth to Static Water Level
PVC 316 87.26
TYPE OF COMPLETION: (Circle One or More):
Gravel Packed, Underreamed, Telescoped,
<input checked="" type="checkbox"/> Natural Development, <input type="checkbox"/> Open Hole, <input type="checkbox"/> Other
(Describe) _____
WELL GROUTED TO A DEPTH OF 0 FEET
Type Grout (circle one): Cement, Bentonite, or Mix

LOG DATA
TYPE OF LOG RUN (Circle One):
<input checked="" type="checkbox"/> No Log Run, <input type="checkbox"/> Electric, <input type="checkbox"/> Gamma Ray, <input type="checkbox"/> Density, <input type="checkbox"/> Sonic, <input type="checkbox"/> Neutron,
Other (Describe) _____
Name of Organization Running Log
Griner Drilling Service, Inc.
GEOLOGIC DATA (Office Use Only)
Surface Elev. Geologic Unit Unit Thickness Depth to Top
Subs. SWL Date Analysis Aquifer Test

SCREEN DATA
Diameter - Inches Length - Feet Slot Size - Inches
4 20 .010
Screen Type Depth to Bottom - Feet
PVC 215

Driller's Remarks
Test Well to be
abandoned

DESCRIPTION OF FORMATIONS ENCOUNTERED	FROM	TO	FORMATIONS (Continued)	FROM	TO
Top Soil	0	2	 AUG 04 1994 Dept. of Environmental Quality Office of Land & Water Resources		
Sand	2	130			
Clay	130	189			
Sand	189	218			
Clay	218	270			
Sand & Clay streaks	270	316			

IF MORE SPACE IS NEEDED, USE BACK

If well telescopes please
sketch and show depths.

GROUND LEVEL

SECTION _____

Please indicate well location X.

ADDITIONAL INFORMATION

If more than one screen,
show location of each on sketch.