	State Well Report		
- listal		For Office Use Only:	
County: Licoly	Mississippi Department of Environmental Quality	Aquifer: <u>H 119</u>	
Permit #:	Office of Land and Water Resources		
Driller: Fitzerald Will Sur	P.O. Box 2309	Weil #:	
Date drilling completed: $4-2-11$.	Jackson, MS 39225 (601)961- 5210	L. S. Elevation:	
Date drilling completed: <u>T-Z-11.</u>	(601)961- 5228 (fax)	E-log #:	
State Law requires that this repo	rt be prepared by the license holder responsible for s within 30 days of completion of drilling of the wel	the work and filed with the	
Information on Well	Owner Well or B	orehole Location	
(Landowner if borehole is not j	for a water well) $3/0 20'40$	Latitude: 31° 33', 452 Longitude: 90° 21, 47	
Owner Name Joe Penn	Latitude: 01 ° 55 ' 15	Longitude: 10 ° ol , 17	
	Method of Lat/Long (circle of	ne): Conventional Survey,	
Mailing Address: Huy SY			
	USGS quad, Hand-hei	d GPS, Survey-grade GPS	
0 /1/ 0	<u>56 1/2 NE 1/2 Sec</u>	5 Twn 7N Rng 8G	
<u>Brockhaven</u> City Sta	ate Zip Code Distance Direction	Nearest Town	
City Sta	ate Zip Code Distance Direction Miles	of	
Telephone No. ()			
·····	Well / Borehole Data 130		
Location of the source of any surface wat Method of dosing and volume of Chlorin	ne used in drilling and development:		
Method of dosing and volume of Chlorin Logs run (circle all applicable): No log n Name of organization running log(s): Purpose of borehole (check one): Water V Seismic	ne used in drilling and development:	Other: d Source Heat Pump	
Method of dosing and volume of Chlorin Logs run (circle all applicable): No log n Name of organization running log(s): Purpose of borehole (check one): Water V Seismic	me used in drilling and development:	Other: d Source Heat Pump	
Method of dosing and volume of Chlorin Logs run (circle all applicable): No log n Name of organization running log(s): Purpose of borehole (check one): Water V Seismic If drilling is not relate	ne used in drilling and development:	Other: d Source Heat Pump	
Method of dosing and volume of Chlorin Logs run (circle all applicable): No log m Name of organization running log(s): Purpose of borehole (check one): Water V Seismic 	ne used in drilling and development:	Other:	
Method of dosing and volume of Chlorin Logs run (circle all applicable). No log m Name of organization running log(s): Purpose of borehole (check one): Water V Seismic If drilling is not relate Purpose of Well (check one): Home If a flowing well, method of flow regulati Static Water Level:feet a Method of Measurement (circle one)	ne used in drilling and development:	Other:	
Method of dosing and volume of Chlorin Logs run (circle all applicable). No log m Name of organization running log(s) Purpose of borehole (check one): Water W Seismic If drilling is not relate Purpose of Well (check one): Home If a flowing well, method of flow regulati Static Water Level:	ne used in drilling and development:	Other:	
Method of dosing and volume of Chlorin Logs run (circle all applicable). No log m Name of organization running log(s): Purpose of borehole (check one): Water V Seismic If drilling is not relate Purpose of Well (check one): Home If a flowing well, method of flow regulati Static Water Level:feet a Method of Measurement (circle one)	ne used in drilling and development:	Other:	
Method of dosing and volume of Chlorin Logs run (circle all applicable). No log m Name of organization running log(s) Purpose of borehole (check one): Water W Seismic If drilling is not relate Purpose of Well (check one): Home If a flowing well, method of flow regulati Static Water Level:	ne used in drilling and development:	Other:	
Method of dosing and volume of Chlorin Logs run (circle all applicable). No log m Name of organization running log(s): Purpose of borehole (check one): Water W Seismic If drilling is not relate Purpose of Well (check one): Home If a flowing well, method of flow regulati Static Water Level:feet a Method of Measurement (circle one) < Well depth:feetfeet Casing length:feet	ne used in drilling and development:	Other:	
Method of dosing and volume of Chlorin Logs run (circle all applicable). No log m Name of organization running $\log(s)$. Purpose of borehole (check one): Water W Seismic If drilling is not relate Purpose of Well (check one): Home If a flowing well, method of flow regulati Static Water Level: Here a Method of Measurement (circle one) (Well depth: Kell grouted to a d Casing length: feet Cass Screen length: (0 feet Scr Screen slot size: O(0 inches	ne used in drilling and development:	Other:	
Method of dosing and volume of Chlorin Logs run (circle all applicable). No log m Name of organization running log(s)	ne used in drilling and development:	Other:	


. - I

REGEIVED

apr 2 1 2011 BY: OLMP

H119


The sketch below only required for water wells

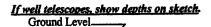

Description of formations encountered must be provided for all wells and boreholes, unless specifically exempted by regulations

Description of Formations Encountered	From (depth)	To (depth)
	Ground Level	
Clay	0	20
clay.	20	60
gauve!	ųο	80
clw/-	80	100
Sand.	100	(20
Curse Sand	120	130
		+
		+
		1
		and the second s

If more than one screen, show location of each on sketch

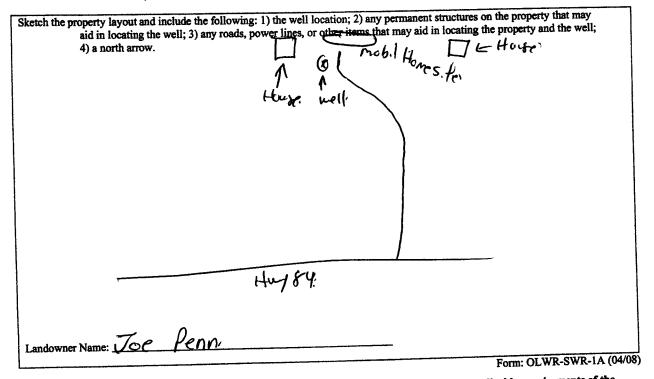

I certify that the well/borehole was drilled, constructed, and completed in accordance with all applicable requirements of the Mississippi Department of Environmental Quality and the Mississippi Department of Health regulations, if applicable, and state

4-2-11 Fizzeval OH 131 Ad Date

Print Name of Responsible Licensee and License No.

Signature of Licensee

RECEIVED

APR 2 1 2011 BY: OHNE

County: Licoln Permit #: Primp Installer's Permit #: Mississippi Departmen Driller: Fitzurald Well fere, Office of Landa P.O.I Date completed: 4-2-11- Jackson (601)	Latitude: 31 ⁰ 33 ⁴ 5. Method of Lat/Long (check of	H Longitude: <u>F0 21 47.</u> 0	
<u><i>Rruckhuen MS</i></u> City State Zip Code	¼¼ Sec_ Distance Direction Miles	of	
Pump Type Circle one Jet Submersible Air Lift Jet Submersible Bucket Piston Turbine Centrifugal Rotary Flowing Well Other (specify):	Diesel Engine Gasol Electric Motor Hand Windmill Othe	or (specify): or:feet	
Pump Test Data Date Well Tested:	Air Line Electric M Other (specify): For flowing well, measured Well yielded	Measuring Water Level Circle one Acasuring Line Stel Tape d shut in head:feet GPM with a drawdown of sthours of pumping	
This is for (circle one): New Well Replacement of F I HEREBY CERTIFY that the above statements are true to the bear <u>BIAC</u> <u>ACCUL</u> , <u>CAQ</u> Print Name of Fump Installer and License No. (if applicable)		Form: OLWR-SWR-1C (U	APR 2 1

۲

APR 2 1 2011 BV: OLIMP