

Hwy 84 E Sec. 18

Lincoln
H 2000
1-14-76

MISSISSIPPI
BOARD OF WATER COMMISSIONERS
416 North State Street
Jackson, Mississippi 39201

134

WATER WELL DRILLERS LOG

Jan. 14 1976 Grenn Water Well Con. Lincoln

date well completed

firm name

county well located

LANDOWNER: Evon White

description of formations encountered

from

to

804 N. Jackson

Citronelle

1

146

Brookhaven, Miss.

(mailing address)

WELL LOCATION:

sec. 8 T 7 N S R 8 E W

1 miles E of Brookhaven
(distance) (direction) (nearest town)

WELL PURPOSE: home
(home, irrigation, municipal, industrial)

WELL COMPLETION DATA:

- (1) diameter (inches) 4
- (2) total depth (feet) 146
- (3) static water level (feet) 23 below above top of ground.
- (4) casing PVC 140
(material) (depth)
4" (size) if telescope see back.
- (5) screen 6' 140'
(length) (depth to top)
.010 PVC
(size) (material)
- (6) pump did not install
(HP) (yield gpm)
(type power)
- (7) electric log no
(yes or no)
(organization running log)
- (8) how well bottom plugged wood


DRILLERS REMARKS:



1976-7-1976

If well telescopes please sketch and show depths.

GROUND LEVEL

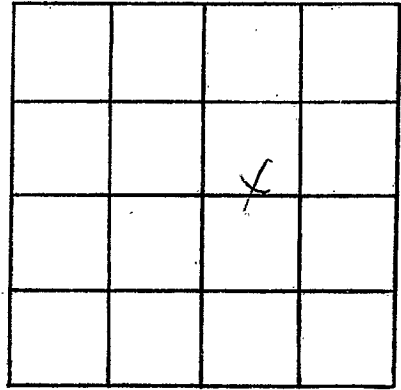

SECTION 8

Please indicate well location X.

ADDITIONAL INFORMATION

If more than one screen, show locations of each on sketch.