

Lincoln
 H 2001
 6-4-76

MISSISSIPPI
 BOARD OF WATER COMMISSIONERS
 416 North State Street
 Jackson, Mississippi 39201

WATER WELL DRILLERS LOG

June 4 1976 Grenn Water Well Lincoln
 date well completed firm name county well located


LANDOWNER:	Description of formations encountered	from	to
Harold Delaughter Route 4 Brookhaven, Miss (mailing address)	Citronelle	0	60
WELL LOCATION:			
sec. 27 T 7 N R 8 E S W			
3 miles E of Brookhaven (distance) (direction) (nearest town)			
WELL PURPOSE: home (home, irrigation, municipal, industrial)			
WELL COMPLETION DATA:			
(1) diameter (inches) 4			
(2) total depth (feet) 60			
(3) static water level (feet) 45 below top of ground.			
(4) casing PVC 54' (material) (depth) 4" If telescope see back. (size)			
(5) screen 6' 54' (length) (depth to top) .010 PVC (size) (material)			
(6) pump did not install (HP) (yield gpm)			
(type power)			
(7) electric log no (yes or no)			
(organization running log)			
(8) how well bottom plugged back wash valve			
DRILLERS REMARKS:			

RECEIVED
 AUG 9 - 1976

MISS. BD. OF WATER COMM

If well telescopes please sketch and show depths.

GROUND LEVEL

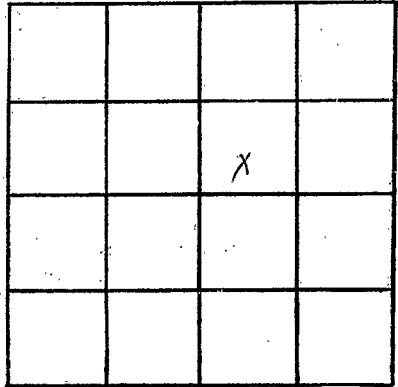

SECTION 21

Please indicate well location X.

ADDITIONAL INFORMATION

Lined area for additional information.

If more than one screen, show locations of each on sketch.