

Lincoln
H 2002
6-26-76

MISSISSIPPI
 BOARD OF WATER COMMISSIONERS
 416 North State Street
 Jackson, Mississippi 39201

WATER WELL DRILLERS LOG

June 26 1976 Grenn Water Well Cont. Lincoln
 date well completed firm name county well located


LANDOWNER: <u>Sam Richardson</u> <u>Brookhaven, Miss.</u>	description of formations encountered <u>Citronelle</u>	from <u>0</u>	to <u>121</u>
(mailing address)			
WELL LOCATION:			
sec. <u>30</u> T. <u>7</u> <u>N</u> R. <u>8</u> <u>E</u> <div style="display: flex; justify-content: space-around; width: 100%;"> S W </div>			
<u>1</u> miles <u>SE</u> of <u>Brookhaven</u> (distance) (direction) (nearest town)			
WELL PURPOSE: <u>home</u> (home, irrigation, municipal, industrial)			
WELL COMPLETION DATA:			
(1) diameter (inches) <u>4</u>			
(2) total depth (feet) <u>121</u>			
(3) static water level (feet) <u>35</u> below top of ground.			
(4) casing <u>PVC</u> , <u>115</u> , (material) (depth) <u>4"</u> (size) if telescope see back.			
(5) screen <u>6'</u> , <u>115'</u> (length) (depth to top) <u>.010</u> , <u>PVC</u> (size) (material)			
(6) pump <u>1/2</u> sub <u>10</u> (HP) (yield gpm) <u>220 electric</u> (type power)			
(7) electric log <u>no</u> (yes or no)			
(organization running log)			
(8) how well bottom plugged, <u>Back wash valve</u>			
DRILLERS REMARKS:			

RECEIVED
 AUG 9 - 1976

MISS. BD. OF WATER COMMISSIONERS

If well telescopes please sketch and show depths.

GROUND LEVEL

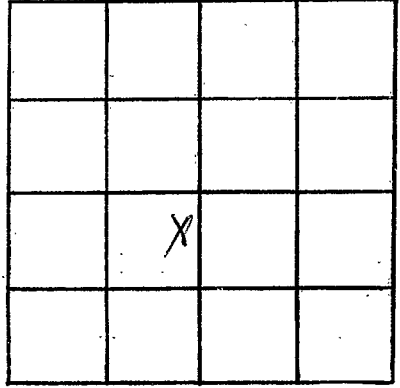

SECTION 3

Please indicate well location X.

ADDITIONAL INFORMATION

Lined area for additional information.

If more than one screen, show locations of each on sketch.