

Lincoln
H 2005
Nov. 16, 1976

MISSISSIPPI
 BOARD OF WATER COMMISSIONERS
 416 North State Street
 Jackson, Mississippi 39201

WATER WELL DRILLERS LOG

Nov. 16 19 76 Grenn Water Well Cont. Lincoln
 date well completed firm name county well located


LANDOWNER:	description of formations encountered	from	to
<u>Aubrey Cox</u>	<u>Citronelle</u>	<u>1</u>	<u>67</u>
<u>Route 4</u>			
<u>Brookhaven, Miss.</u> (mailing address)			
WELL LOCATION:			
sec. <u>34</u> T. <u>7</u> (N) R. <u>8</u> (E)			
<u>3</u> miles <u>Seast</u> of <u>Brookhaven</u> (distance) (direction) (nearest town)			
WELL PURPOSE: <u>XX Home</u> (home, irrigation, municipal, industrial)			
WELL COMPLETION DATA:			
(1) diameter (inches)	<u>6"</u>		
(2) total depth (feet)	<u>67</u>		
(3) static water level (feet)	<u>32</u>	<u>below</u>	<u>above</u>
top of ground.			
(4) casing	<u>PVC</u>	<u>61</u>	
(material) (depth)			
<u>4"</u> If telescope see back. (size)			
(5) screen	<u>6'</u>	<u>61'</u>	
(length) (depth to top)			
<u>.010</u> <u>PVC</u> (size) (material)			
(6) pump	<u>did not install</u>		
(HP) (yield gpm)			
(type power)			
(7) electric log	<u>no</u>		
(yes or no)			
(organization running log)			
(8) how well bottom plugged	<u>back wash valve</u>		
DRILLERS REMARKS:			

RECEIVED
 DEC 22 1976

MISS. BD. OF WATER COMMISSIONERS

If well telescopes please sketch and show depths.

GROUND LEVEL

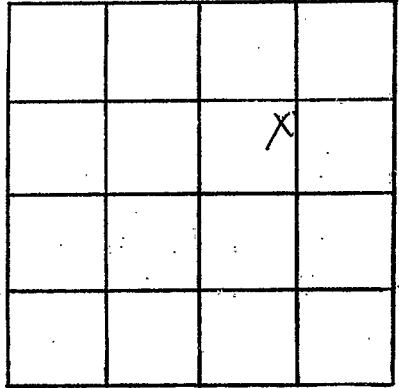

SECTION 34

Please indicate well location X.

ADDITIONAL INFORMATION

If more than one screen,
show locations of each on sketch.