

Lincoln
17 2006
2/15/77

MISSISSIPPI
 BOARD OF WATER COMMISSIONERS
 416 North State Street
 1322 Jackson, Mississippi 39201

WATER WELL DRILLERS LOG

Feb. 15 1977 Grenn Water Well Cont. Lincoln
 date well completed firm name county well located


LANDOWNER: James Leggett	description of fomations encountered	from	to
Route 4, Box 5 Brookhaven, Miss. (mailing address)			
WELL LOCATION:			
sec. <u>8</u> T <u>7</u> N R <u>8</u> E S W			
<u>1/2</u> miles <u>E</u> of <u>Brookhaven</u> (distance) (direction) (nearest town)			
WELL PURPOSE: home (home, irrigation, municipal, industrial)			
WELL COMPLETION DATA:			
(1) diameter (inches) <u>4</u>			
(2) total depth (feet) <u>66</u>			
(3) static water level (feet) <u>45</u> below top of ground. above			
(4) casing <u>PVC</u> , <u>60°</u> (material) (depth) <u>4"</u> (size) if telescope see back.			
(5) screen <u>6°</u> <u>60°</u> (length) (depth to top)			
<u>.010</u> <u>PVC</u> (size) (material)			
(6) pump <u>did not install</u> (HP) (yield gpm)			
(type power)			
(7) electric log <u>no</u> (yes or no)			
(organization running log)			
(8) how well bottom plugged <u>back wash valve</u>			
DRILLERS REMARKS:			

RECEIVED

MAR 25 1977

If well telescopes please sketch and show depths.

GROUND LEVEL

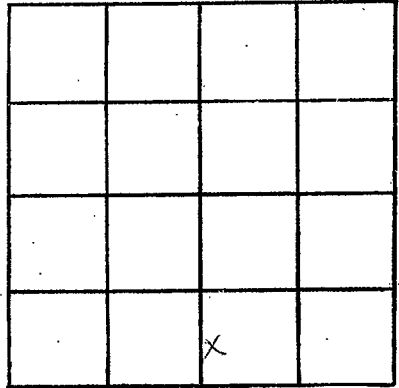

SECTION 8

Please indicate well location X.

ADDITIONAL INFORMATION

If more than one screen, show locations of each on sketch.