

Lincoln  
H 2007  
3-11-77

MISSISSIPPI  
 BOARD OF WATER COMMISSIONERS  
 416 North State Street  
 130 Jackson, Mississippi 39201  
 WATER WELL DRILLERS LOG

March 11 1977 Grenn Water Well Cont. Lincoln  
 date well completed firm name county well located


LANDOWNER: <u>Jimmy Cummins</u>	description of fomations encountered	from	to
<u>Box 542</u>			
<u>Brookhaven, Miss.</u> (mailing address)			
WELL LOCATION: <u>sec 30 T 7 (N) R 8 (E)</u> <u>1</u> miles <u>S</u> of <u>Brookhaven</u> (distance) (direction) (nearest town)			
WELL PURPOSE: <u>home</u> (home, irrigation, municipal, industrial)			
WELL COMPLETION DATA:			
(1) diameter (inches) <u>6"</u>			
(2) total depth (feet) <u>131</u>			
(3) static water level (feet) <u>22</u> <u>below</u> top of ground. <u>above</u>			
(4) casing <u>PVC</u> , <u>125'</u> (material) (depth) <u>4"</u> if telescope see back. (size)			
(5) screen <u>6'</u> , <u>125'</u> (length) (depth to top) <u>.010</u> , <u>PVC</u> (size) (material)			
(6) pump <u>1/2 sub</u> <u>10</u> (HP) (yield gpm) <u>electricity</u> (type power)			
(7) electric log <u>no</u> (yes or no)  (organization running log)			
(8) how well bottom plugged <u>back wash valve</u>			
DRILLERS REMARKS:			

RECEIVED  
 APR 22 1977

MISSISSIPPI BOARD OF WATER COMMISSIONERS

If well telescopes please sketch and show depths.

GROUND LEVEL

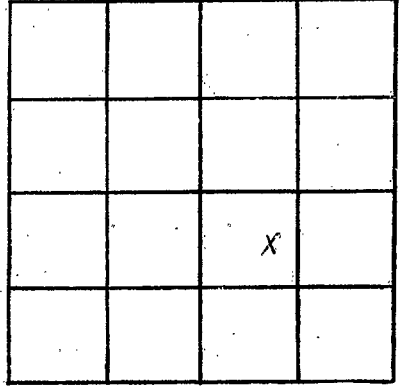

SECTION 30

Please indicate well location X.

ADDITIONAL INFORMATION

If more than one screen, show locations of each on sketch.