

LINCOLN  
 H 2013  
 3/28/78

MISSISSIPPI  
 BOARD OF WATER COMMISSIONERS  
 416 North State Street  
 Jackson, Mississippi 39201

WATER WELL DRILLERS LOG

March 28 1978 Grenn Water Well Contr. Lincoln  
 date well completed firm name county well located

LANDOWNER: David Douglas  
 Route 4  
 Brookhaven, Miss.  
 (mailing address)

description of formations encountered  
 Citronelle  
 from 1 to 71

WELL LOCATION:  
 sec. 27 T. 7 N R. 8 E  
 S W  
 3 SE Brookhaven  
 (distance) miles (direction) of (nearest town)

WELL PURPOSE: home  
 (home, irrigation, municipal, industrial)

- WELL COMPLETION DATA:
- (1) diameter (inches) 6
  - (2) total depth (feet) 71
  - (3) static water level (feet) 45 below above top of ground
  - (4) casing PVC 59'  
 (material) (depth)  
 4" if telescope see back.  
 (size)
  - (5) screen R 12' 59'  
 (length) (depth to top)  
 .010 PVC  
 (size) (material)
  - (6) pump 1/2 HP sub 10  
 (HP) (yield gpm)  
 electricity  
 (type power)
  - (7) electric log no  
 (yes or no)

(organization running log)

(8) how well bottom plugged back wash valve

DRILLERS REMARKS:


RECEIVED

JUL 17 1978

MISS. BD. OF WATER COMMISSIONERS

If well telescopes please sketch and show depths.

GROUND LEVEL

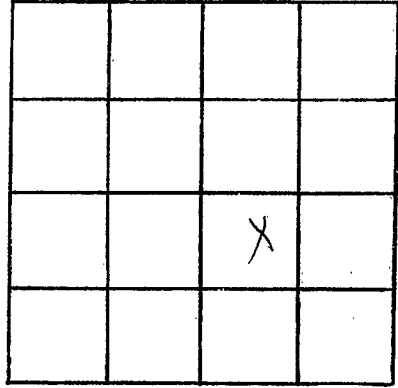

SECTION 27

Please indicate well location X.

ADDITIONAL INFORMATION

If more than one screen, show locations of each on sketch.