

LINGOLN
 H 2014
 6/9/78

MISSISSIPPI
 BOARD OF WATER COMMISSIONERS
 416 North State Street
 Jackson, Mississippi 39201

WATER WELL DRILLERS LOG

June 9 1978 Grenn Water Well Cont. Lincoln
 date well completed firm name county well located

LANDOWNER: Loyd Hudgins
P. O. Box 1302
Brookhaven, Miss.
 (mailing address)

| description of formations encountered | from | to |
|---------------------------------------|------|----|
| Citronelle | 1 | 87 |

WELL LOCATION:
 sec. 8 T-7 N R-8 E
 S W
1/2 miles E of Brookhaven
 (distance) (direction) (nearest town)

WELL PURPOSE: home
 (home, irrigation, municipal, industrial)

- WELL COMPLETION DATA:
- (1) diameter (inches) 6"
 - (2) total depth (feet) 87'
 - (3) static water level (feet) 75' below above-
 top of ground.
 - (4) casing PVC 75'
4" (material) (depth)
 - ~~XXXX~~ if telescope see back.
 (size)
 - (5) screen 12' 75'
 (length) (depth to top)
 - .010 PVC
 (size) (material)
 - (6) pump 1/2 HP Sub 10
 (HP) (yield gpm)
 - Electricity
 (type power)
 - (7) electric log no
 (yes or no)
 - (organization running log)

(8) how well bottom plugged back wash valve


DRILLERS REMARKS:

RECEIVED
 JUL 17 1978

MISS. BD. OF WATER COMM

If well telescopes please sketch and show depths.

GROUND LEVEL

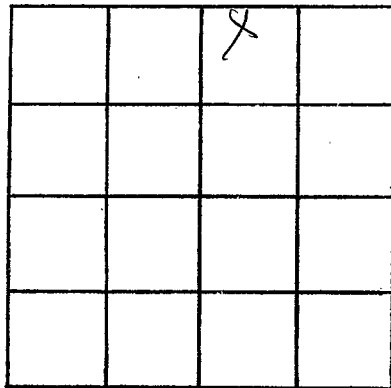

SECTION 8

Please indicate well location X.

ADDITIONAL INFORMATION

Lined area for additional information.

If more than one screen, show locations of each on sketch.