

LINCOLN
 H 2015
 6/19/78

MISSISSIPPI
 BOARD OF WATER COMMISSIONERS
 416 North State Street
 Jackson, Mississippi 39201

WATER WELL DRILLERS LOG

June 19 1978 Grenn Water Well Contr. Lincoln
 date well completed firm name county well located

LANDOWNER: Bill Cannon
 Route 3
 Bogue Chitto, Miss.
 (mailing address)

description of formations encountered	from	to
Citronelle	1	70

WELL LOCATION:
 sec. 32 T. 7 N R. 8 E
 S W
 3 miles SE of Brookhaven
 (distance) (direction) (nearest town)

WELL PURPOSE: home
 (home, irrigation, municipal, industrial)

- WELL COMPLETION DATA:
- (1) diameter (inches) 6"
 - (2) total depth (feet) 60'
 - (3) static water level (feet) 50' below top of ground.
 - (4) casing PVC 58' (material) (depth)
 4" (size) if telescope see back.
 - (5) screen 12' 58' (length) (depth to top)
 .010 PVC (size) (material)
 - (6) pump did not install (HP) (yield gpm)
 - (type power)
 - (7) electric log no (yes or no)
 - (organization running log)
 - (8) how well bottom plugged back wash valve


RECEIVED
 JUL 17 1978

DRILLERS REMARKS:

MISS. BD. OF WATER COMMISSIONERS

If well telescopes please sketch and show depths.

GROUND LEVEL

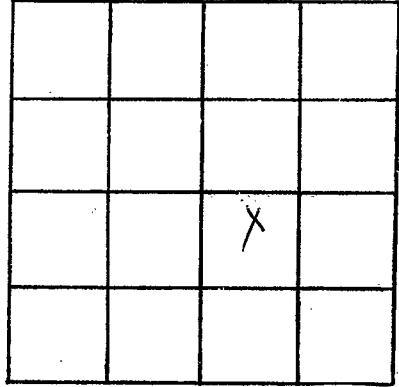

SECTION 32

Please indicate well location X.

ADDITIONAL INFORMATION

If more than one screen,
show locations of each on sketch.