

5 sec. 18?

LINCOLN
H <u>2016</u>
12-18-78

MISSISSIPPI  
BOARD OF WATER COMMISSIONERS  
416 North State Street  
Jackson, Mississippi 39201

WATER WELL DRILLERS LOG

Dec. 18 19 78 Grenn Water Well Cont. Lincoln  
date well completed firm name county well located

LANDOWNER: <u>Joe Robins</u> <u>128 N. First St.</u> <u>Brookhaven, Miss.</u> <small>(mailing address)</small>	description of formations encountered <u>Citronelle</u>	from <u>1</u>	to <u>102</u>
WELL LOCATION: sec. <u>20</u> T <u>7</u> N R <u>8</u> E S W <u>1</u> miles <u>SE</u> of <u>Brookhaven</u> <small>(distance) (direction) (nearest town)</small>			
WELL PURPOSE: <u>home</u> <small>(home, irrigation, municipal, industrial)</small>			
WELL COMPLETION DATA: (1) diameter (inches) <u>4</u> (2) total depth (feet) <u>102</u> (3) static water level (feet) <u>55</u> <u>below</u> above top of ground. (4) casing <u>PVC</u> <u>90'</u> <small>(material) (depth)</small> <u>4"</u> <small>(size)</small> If telescope see back. (5) screen <u>12'</u> <u>90'</u> <small>(length) (depth to top)</small> <u>.010</u> <u>PVC</u> <small>(size) (material)</small> (6) pump <u>did not install</u> <small>(HP) (yield gpm)</small>  <small>(type power)</small> (7) electric log <u>TD</u> <small>(yes or no)</small>  <small>(organization running log)</small> (8) how well bottom plugged <u>back wash valve</u>			
DRILLERS REMARKS:			


Miss. Board of Water Comm.

FEB 8 1979

RECEIVED

If well telescopes please sketch and show depths.

GROUND LEVEL

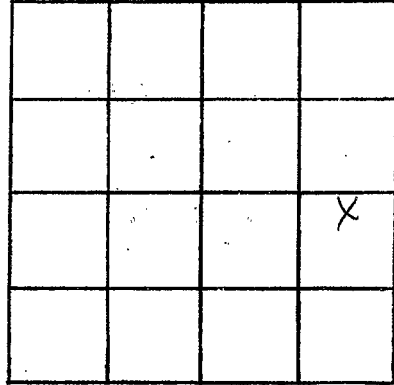

SECTION 20

Please indicate well location X.

ADDITIONAL INFORMATION

A series of horizontal lines for writing additional information.

If more than one screen, show locations of each on sketch.