

Lincoln
 H 2017
 5-8-79

MISSISSIPPI
 BOARD OF WATER COMMISSIONERS
 416 North State Street
 Jackson, Mississippi 39201

WATER WELL DRILLERS LOG

May 8, 1979 Grenn Water Well Cont. Lincoln
 date well completed firm name county well located

LANDOWNER: John Gilliam
 Route 2
 Bogue Chitto, Miss.
 (mailing address)

description of formations encountered
 Citronelle
 from 1 to 157

WELL LOCATION:
 sec 31 T 7 N R 8 E
 S W
 2 miles S of Brookhaven
 (distance) (direction) (nearest town)

WELL PURPOSE: home
 (home, irrigation, municipal, industrial)

WELL COMPLETION DATA:
 (1) diameter (inches) 4"
 (2) total depth (feet) 157
 (3) static water level (feet) 55 below top of ground.
 (4) casing PVC 145
 (material) (depth)
 4" if telescope see back.
 (size)
 (5) screen 12" 145"
 (length) (depth to top)
 .010 PVC
 (size) (material)
 (6) pump 3/4 HP sub 10
 (HP) (yield gpm)
 220
 (type power)
 (7) electric log no
 (yes or no)
 (organization running log)
 (8) how well bottom plugged
 back wash valve

DRILLERS REMARKS:


Miss. Board of Water Comm.

JUL 9 1979

RECEIVED

If well telescopes please sketch and show depths.

GROUND LEVEL

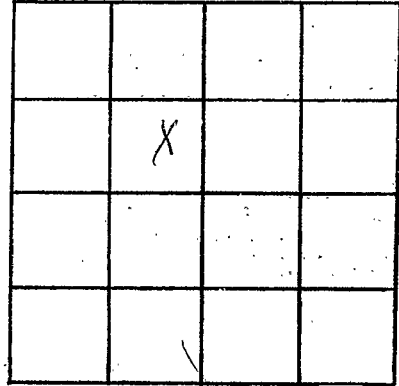

SECTION 31

Please indicate well location X.

ADDITIONAL INFORMATION

If more than one screen,
show locations of each on sketch.