

LINCOLN

H 2018

7/14/79

MISSISSIPPI BOARD OF WATER COMMISSIONERS
416 North State Street
Jackson, Mississippi 39201

WATER WELL DRILLERS LOG

June 14 19 79 Grenn Water Well Cont.. Lincoln

date well completed

firm name

county well located

LANDOWNER: Bettie Lefort

Route 2

Bogue Chitto, Miss.

(mailing address)

description of formations encountered

from

to

Citronetle

1

98

WELL LOCATION:

sec. 32 T 7 N R 8 E
S W

2 miles SE of Brookhaven
(distance) (direction) (nearest town)

WELL PURPOSE: home
(home, irrigation, municipal, industrial)

WELL COMPLETION DATA:

- (1) diameter (inches) 4
- (2) total depth (feet) 98
- (3) static water level (feet) 65 below above
top of ground.
- (4) casing PVC 86'
(material) (depth)
4" (size) if telescope see back.
- (5) screen 12' 86'
(length) (depth to top)
.010 PVC
(size) (material)
- (6) pump did not install
(HP) (yield gpm)
- (type power)
- (7) electric log no
(yes or no)
- (organization running log)
- (8) how well bottom plugged
back wash valve

DRILLERS REMARKS:


Miss. Board of Water Comm.

AUG 16 1979

RECEIVED

If well telescopes please sketch and show depths.

GROUND LEVEL

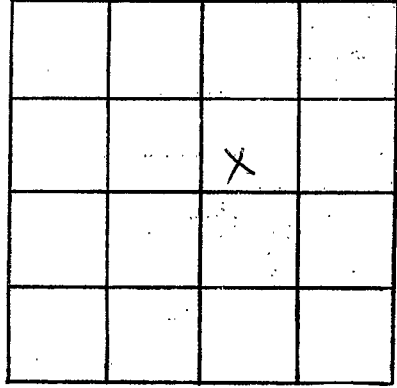

SECTION 32

Please indicate well location X.

ADDITIONAL INFORMATION

If more than one screen,
show locations of each on sketch.