

Lincoln
H 2019
8-31-79

MISSISSIPPI
 BOARD OF WATER COMMISSIONERS
 416 North State Street
 Jackson, Mississippi 39201

WATER WELL DRILLERS LOG

Aug. 31 19 79 Grem Water Well Cont. Lincoln


date well completed firm name county well located

LANDOWNER: Dale Hutcherson Route 1	description of formations encountered Citronelle	from 1	to 65
Brookhaven, Miss. (mailing address)			
WELL LOCATION: sec. 21 T 7 ^N / _S R 8 ^E / _W 3 miles E of Brookhaven (distance) (direction) (nearest town)			
WELL PURPOSE: home (home, irrigation, municipal, industrial)			
WELL COMPLETION DATA:			
(1) diameter (inches) 4			
(2) total depth (feet) 65			
(3) static water level (feet) 45 below top of ground. above			
(4) casing PVC 53 (material) (depth) 4" if telescope see back. (size)			
(5) screen 12' 53 (length) (depth to top) .010 PVC (size) (material)			
(6) pump did not install (HP) (yield gpm) (type power)			
(7) electric log no (yes or no) (organization running log)			
(8) how well bottom plugged back wash valve			
DRILLERS REMARKS:			

*Rec'd 9-27-79
DWH*

If well telescopes please sketch and show depths.

GROUND LEVEL

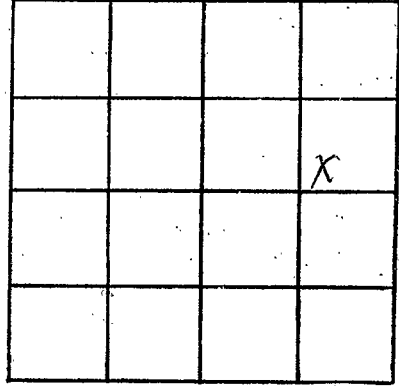

SECTION 21

Please indicate well location X.

ADDITIONAL INFORMATION

If more than one screen, show locations of each on sketch.