

Lincoln  
H 224  
9-26-80

MISSISSIPPI  
BOARD OF WATER COMMISSIONERS  
416 North State Street  
Jackson, Mississippi 39201

WATER WELL DRILLERS LOG

Sept. 26 1980 Grenn Water Well Cont. Lincoln  
date well completed firm name county well located

LANDOWNER: J. W. Williams  
Route 6. Box 10  
Brookhaven, Miss.  
(mailing address)

description of fomations encountered  
Citronelle  
from 1 to 155

WELL LOCATION:  
sec. 8 T 7 N S R 8 E W  
1 miles NE of Brookhaven  
(distance) (direction) (nearest town)

WELL PURPOSE: home  
(home, irrigation, municipal, industrial)

WELL COMPLETION DATA:  
(1) diameter (inches) 4  
(2) total depth (feet) 155  
(3) static water level (feet) 48 below above top of ground.  
(4) casing PVC 145  
(material) (depth)  
4" if telescope see back.  
(size)  
(5) screen 10' 145'  
(length) (depth to top)  
.010 PVC  
(size) (material)  
(6) pump 1/2 sub 10  
(HP) (yield gpm)  
electricity  
(type power)  
(7) electric log no  
(yes or no)  
(organization running log)


(8) how well bottom plugged  
back wash valve  
DRILLERS REMARKS:

DEPT. OF NATURAL RESOURCES  
BUREAU OF LAND & WATER RESOURCES  
OCT 23 1980

RECEIVED

If well telescopes please sketch and show depths.

GROUND LEVEL

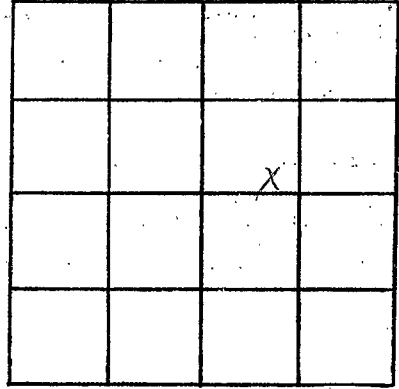

SECTION 8

Please indicate well location: X.

ADDITIONAL INFORMATION

A series of horizontal lines for writing additional information, starting below the 'ADDITIONAL INFORMATION' header and extending down to the bottom of the page.

If more than one screen, show locations of each on sketch.