

Lincoln
H 2025
10-24-80

MISSISSIPPI
BOARD OF WATER COMMISSIONERS
416 North State Street
Jackson, Mississippi 39201

WATER WELL DRILLERS LOG

Oct. 24 1980 80 Gremm Water Well Cont. Lincoln
date well completed firm name county well located

LANDOWNER:	description of formations encountered	from	to
John Haneycutt 612 White Oak Dr. Brookhaven, Miss. (mailing address)	Citronelle	1	150
WELL LOCATION:			
sec. <u>7</u> T. <u>7</u> N R. <u>8</u> E S W <u>1/2</u> miles N of Brookhaven (distance) (direction) (nearest town)			
WELL PURPOSE: home (home, irrigation, municipal, industrial)			
WELL COMPLETION DATA:			
(1) diameter (inches) <u>4</u>			
(2) total depth (feet) <u>150</u>			
(3) static water level (feet) <u>60</u> below top of ground.			
(4) casing <u>PVC</u> <u>140</u> (material) (depth) <u>4 1/2</u> if telescope see back. (size)			
(5) screen <u>10'</u> <u>140'</u> (length) (depth to top) <u>.010</u> <u>PVC</u> (size) (material)			
(6) pump <u>1/2</u> sub <u>10</u> (HP) (yield gpm)			
<u>electricity</u> (type power)			
(7) electric log <u>no</u> (yes or no)			
<u>(organization running log)</u>			
(8) how well bottom plugged <u>back wash valve</u>			
DRILLERS REMARKS:			


DEPT. OF NATURAL RESOURCES
BUREAU OF LAND & WATER RESOURCES

JAN 12 1981

RECEIVED

If well telescopes please sketch and show depths.

GROUND LEVEL

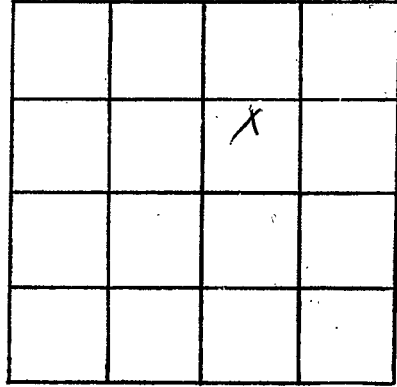

SECTION 7

Please indicate well location X.

ADDITIONAL INFORMATION

If more than one screen, show locations of each on sketch.