

Lincoln
 H 2026
 10-28-80

MISSISSIPPI
 BOARD OF WATER COMMISSIONERS
 416 North State Street
 Jackson, Mississippi 39201

WATER WELL DRILLERS LOG

Oct. 28 1980 Grenn Water Well Cont. Lincoln
 date well completed firm name county well located

LANDOWNER: John Damico
 Route 4
 Brookhaven, Miss.
 (mailing address)

description of formations encountered
 Citronelle from 1 to 65

WELL LOCATION:
 sec 19 T 7 N R 8 E
 S W
 1/2 miles S of Brookhaven
 (distance) (direction) (nearest town)

WELL PURPOSE: home
 (home, irrigation, municipal, industrial)


- WELL COMPLETION DATA:
- (1) diameter (inches) 4
 - (2) total depth (feet) 65
 - (3) static water level (feet) 23 below above top of ground.
 - (4) casing PVC 55
 (material) (depth)
 4" if telescope see back.
 (size)
 - (5) screen 10' 55'
 (length) (depth to top)
 .010 PVC
 (size) (material)
 - (6) pump 1/2 sub 8
 (HP) (yield gpm)
 electricity
 (type power)
 - (7) electric log no
 (yes or no)
- (organization running log)
- (8) how well bottom plugged back wash valve

DEPT. OF NATURAL RESOURCES
 BUREAU OF LAND & WATER RESOURCES
 JAN 12 1981
 RECEIVED

DRILLERS REMARKS:

If well telescopes please
sketch and show depths.

GROUND LEVEL

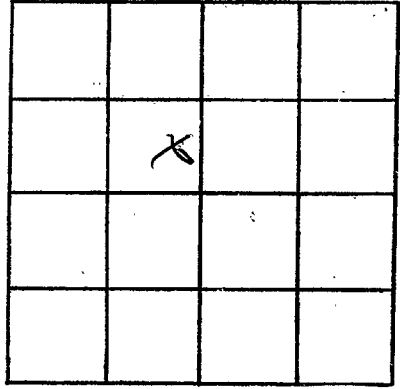

SECTION 19

Please indicate well location X.

ADDITIONAL INFORMATION

If more than one screen,
show locations of each on sketch.