

Lincoln
H 2027
11-4-80

MISSISSIPPI
BOARD OF WATER COMMISSIONERS
416 North State Street
Jackson, Mississippi 39201

WATER WELL DRILLERS LOG

Nov. 4 1980 Grenn Water Well Cont. Lincoln
date well completed firm name county well located

LANDOWNER: Tommy Hill
Route 4, Box 325
Brookhaven, Miss.
(mailing address)

description of fomations encountered
Citronelle
from 1 to 110

WELL LOCATION:
sec 30 T 7 N R 8 E
S W
1 miles S of Brookhaven
(distance) (direction) (nearest town)

WELL PURPOSE: home
(home, irrigation, municipal, industrial)

- WELL COMPLETION DATA:
- (1) diameter (inches) 4
 - (2) total depth (feet) 110
 - (3) static water level (feet) 35 below top of ground.
 - (4) casing PVC 100 (material) (depth)
4" If telescope see back. (size)
 - (5) screen 10' 100' (length) (depth to top)
.010 PVC (size) (material)
 - (6) pump did not install (HP) (yield gpm)
 - (type power)
 - (7) electric log no (yes or no)
 - (organization running log)

(8) how well bottom plugged
back wash valve

DRILLERS REMARKS:


DEPT. OF NATURAL RESOURCES
BUREAU OF LAND & WATER RESOURCES

JAN 12 1981

RECEIVED

If well telescopes please sketch and show depths.

GROUND LEVEL

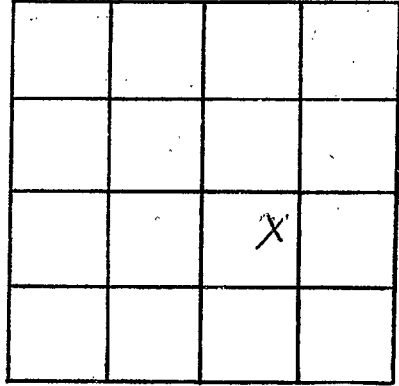

SECTION 30

Please indicate well location X.

ADDITIONAL INFORMATION

If more than one screen,
show locations of each on sketch.