

LINCOLN
H 2030
6-8-81

MISSISSIPPI
BOARD OF WATER COMMISSIONERS
416 North State Street
Jackson, Mississippi 39201

WATER WELL DRILLERS LOG

June 8 1981 Grenn Water Well Cont. Lincoln
date well completed firm name county well located

| LANDOWNER: Mike Ellis Gen. Del. | description of formations encountered Citronelle | from 1 | to 89 |
|--|---|-----------|----------|
| Brookhaven, Ms. (mailing address) | | | |
| WELL LOCATION: sec. 32 T 7 N R 8 E S W 3 miles SE of Brookhaven (distance) (direction) (nearest town) | | | |
| WELL PURPOSE: home (home, irrigation, municipal, industrial) | | | |
| WELL COMPLETION DATA: (1) diameter (inches) 4 (2) total depth (feet) 89 (3) static water level (feet) 60 below above top of ground. (4) casing PVC, 79' (material) (depth) 4" If telescope see back. (size) (5) screen 10' , 79' (length) (depth to top) 010 PVC (size) (material) (6) pump 1/2 sub 8 (HP) (yield gpm) electricity (type power) (7) electric log no (yes or no) (organization running log) | | | |
| (8) how well bottom plugged back wash valve DRILLERS REMARKS: | | | |


DEPT. OF NATURAL RESOURCES
BUREAU OF LAND & WATER RESOURCES

AUG 14 1981

RECEIVED

If well telescopes please sketch and show depths.

GROUND LEVEL

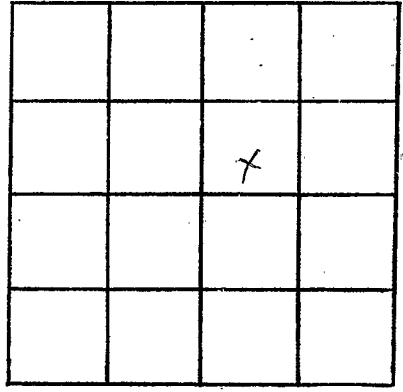

SECTION 32

Please indicate well location X.

ADDITIONAL INFORMATION

Lined area for additional information.

If more than one screen, show locations of each on sketch.