

Lincoln
H 2032
9-4-81

MISSISSIPPI DEPARTMENT OF NATURAL RESOURCES
Bureau of Land and Water Resources
Southport Mall
P.O. Box 10631
Jackson, Mississippi 39209
WATER WELL DRILLERS LOG

Sept. 4 1981 Grenn Water Well Lincoln
date well completed firm name county well located

LANDOWNER: <u>Sam Robin</u>	description of formations encountered	from	to
<u>Rt. 1, Box 274</u>	<u>Citronelle</u>	<u>1</u>	<u>87</u>
<u>Brookhaven, Ms.</u> (mailing address)			
WELL LOCATION:			
sec. <u>20</u> T <u>7</u> <u>N</u> S R <u>8</u> <u>E</u> W			
<u>3</u> miles <u>E</u> of <u>Brookhaven</u> (distance) (direction) (nearest town)			
WELL PURPOSE: <u>home</u> (home, irrigation, municipal, industrial)			
WELL COMPLETION DATA:			
(1) diameter (inches) <u>8 4</u>			
(2) total depth (feet) <u>87</u>			
(3) static water level (feet) <u>18</u> below above top of ground.			
(4) casing <u>PVC</u> <u>77</u> (material) (depth) <u>4"</u> (size) if telescope see back.			
(5) screen <u>10'</u> <u>77'</u> (length) (depth to top) <u>.010</u> <u>PVC</u> (size) (material)			
(6) pump <u>1/2 sub</u> <u>8</u> (HP) (yield gpm)			
electricity (type power)			
(7) electric log <u>no</u> (yes or no)			
<u></u> (organization running log)			
(8) how well bottom plugged <u></u> <u>back wash valve</u>			
DRILLERS REMARKS:			


DEPT. OF NATURAL RESOURCES
BUREAU OF LAND & WATER RESOURCES

OCT 20 1981

RECEIVED

If well telescopes please
sketch and show depths.

GROUND LEVEL

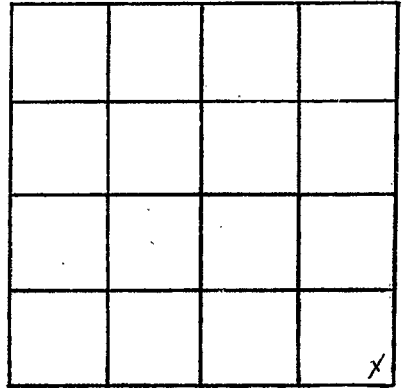

SECTION 20

Please indicate well location X.

ADDITIONAL INFORMATION

If more than one screen,
show locations of each on sketch.