

Lincoln  
H 2033  
9-9-81

MISSISSIPPI DEPARTMENT OF NATURAL RESOURCES  
 Bureau of Land and Water Resources  
 Southport Mall  
 P.O. Box 10631  
 Jackson, Mississippi 39209  
**WATER WELL DRILLERS LOG**

Sept. 9 19 81 Grenn Water Well Lincoln  
 date well completed firm name county well located

LANDOWNER: Charles Ellis  
Route 6, Box 116-G  
Brookhaven, Ms.  
 (mailing address)

description of formations encountered	from	to
Citronelle	1	65

WELL LOCATION:  
 sec. 32 T 7 N R. 8 E  
B miles SE of Brookhaven  
 (distance) (direction) (nearest town)

WELL PURPOSE: home  
 (home, irrigation, municipal, industrial)

WELL COMPLETION DATA:

(1) diameter (inches) 4

(2) total depth (feet) 65

(3) static water level (feet) 38 below above top of ground.

(4) casing PVC 55  
 (material) (depth)  
4" if telescope see back.  
 (size)

(5) screen 10' 55'  
 (length) (depth to top)  
.010 PVC  
 (size) (material)

(6) pump 1/2 sub 8  
 (HP) (yield gpm)  
electricity  
 (type power)

(7) electric log no  
 (yes or no)  
 (organization running log)


(8) how well bottom plugged back wash valve

DRILLERS REMARKS:

DEPT. OF NATURAL RESOURCES  
 BUREAU OF LAND & WATER RESOURCES  
 RECEIVED  
 OCT 20 1981

If well telescopes please sketch and show depths.

GROUND LEVEL

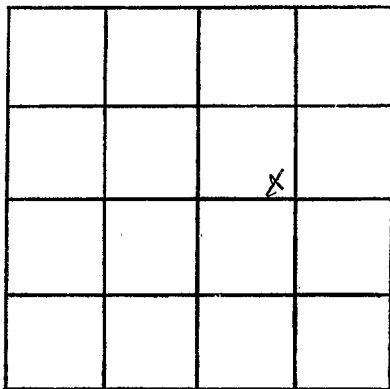

SECTION 32

Please indicate well location X.

ADDITIONAL INFORMATION

If more than one screen, show locations of each on sketch.