

MISSISSIPPI DEPARTMENT OF NATURAL RESOURCES
 Bureau of Land and Water Resources
 Southport Mall
 P.O. Box 10631
 Jackson, Mississippi 39209
WATER WELL DRILLERS LOG

Lincoln
 11
 2039

1-5-1983 date well completed
 83 Grenn Water Well firm name
 Lincoln county well located

LANDOWNER:	description of formations encountered	from	to
Escambia Wood Preserving Co. #3 P.O. Box 766	Clay	1	25
Brookhaven, Ms. (mailing address)	sand	25	70
	gravel	70	103

WELL LOCATION:
 sec. 6 T 7 N R 8 E
 S W
 1/4 miles N of Brookhaven
 (distance) (direction) (nearest town)

WELL PURPOSE: Monitoring
 (home, irrigation, municipal, industrial)

WELL COMPLETION DATA:

(1) diameter (inches) 4

(2) total depth (feet) 103

(3) static water level (feet) 69 below above top of ground.

(4) casing PVC 93'
 (material) (depth)
4"
 (size) if telescope see back.

(5) screen 10' 93'
 (length) (depth to top)
.010 PVC
 (size) (material)

(6) pump did not install
 (HP) (yield gpm)
 (type power)

(7) electric log no
 (yes or no)
 (organization running log)

(8) how well bottom plugged
back wash valve

DRILLERS REMARKS:


DEPT. OF NATURAL RESOURCES
 BUREAU OF LAND & WATER RESOURCES

FEB 28 1983

RECEIVED

If well telescopes please sketch and show depths.

GROUND LEVEL

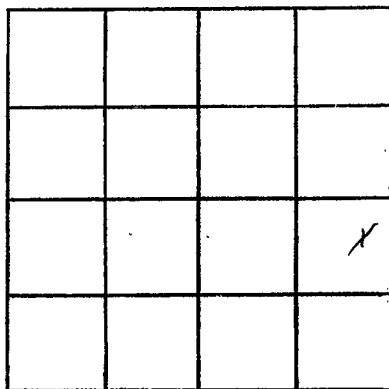

SECTION 6

Please indicate well location X.

ADDITIONAL INFORMATION

If more than one screen, show locations of each on sketch.