

MISSISSIPPI DEPARTMENT OF NATURAL RESOURCES  
 Bureau of Land and Water Resources  
 Southport Mall  
 P.O. Box 10631  
 Jackson, Mississippi 39209  
**WATER WELL DRILLERS LOG**

*Lincoln*  
**H**  
 20 40

*Feb. 21* 1983 *News Miller* *Lincoln*  
 date well completed firm name county well located

LANDOWNER:  
*James Rushing*  
*Breckhaus*  
 (mailing address)

description of formations encountered	from	to
<i>Red clay</i>	<i>0</i>	<i>19</i>
<i>Chalky Red sand</i>	<i>19</i>	<i>28</i>
<i>gray silt sand</i>	<i>28</i>	<i>54</i>
<i>pink chalk</i>	<i>54</i>	<i>130</i>
<i>lumpy sand</i>		
<i>coarse sand</i>	<i>130</i>	<i>145</i>

WELL LOCATION:  
 sec. 10 T 7 N R. 8 E  
1 1/2 miles E of *Breckhaus*  
 (distance) (direction) (nearest town)

WELL PURPOSE: *house*  
 (home, irrigation, municipal, industrial)

- WELL COMPLETION DATA:
- (1) diameter (inches) 4"
  - (2) total depth (feet) 145
  - (3) static water level (feet) 50 below top of ground.
  - (4) casing plastic, Patton  
 (material) (depth)
  - if telescope see back.  
 (size)
  - (5) screen 5' 140'  
 (length) (depth to top)
  - 4" plastic  
 (size) (material)
  - (6) pump 1/2 10  
 (HP) (yield gpm)
  - Elect  
 (type power)
  - (7) electric log no  
 (yes or no)
  - (organization running log)

(8) how well bottom plugged  
*Plastic back wash*


DRILLERS REMARKS:

DEPT. OF NATURAL RESOURCES  
 BUREAU OF LAND & WATER RESOURCES

*JUN 17 1983*  
**RECEIVED**

If well telescopes please sketch and show depths.

GROUND LEVEL

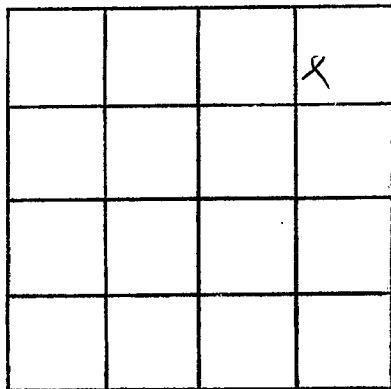

SECTION 10

Please indicate well location X.

ADDITIONAL INFORMATION

If more than one screen,  
show locations of each on sketch.