

Lincoln
H
2041

MISSISSIPPI DEPARTMENT OF NATURAL RESOURCES
Bureau of Land and Water Resources
Southport Mall
P.O. Box 10631
Jackson, Mississippi 39209
WATER WELL DRILLERS LOG

May 6 19 83 Grenn Water Well Lincoln
date well completed firm name county well located

LANDOWNER: Escambia Wood
Wood Preserving Co.
P.O. Box 766
Brookhaven, MS.
Well # 4
(mailing address)

description of formations encountered	from	to
	Clay	1
Sand & Gravel	25	105

WELL LOCATION:
sec. 6 T 7 N R 8 E
S W
1/4 miles North of Brookhaven
(distance) (direction) (nearest town)

WELL PURPOSE: monitoring
(home, irrigation, municipal, industrial)

- WELL COMPLETION DATA:
- (1) diameter (inches) 4
 - (2) total depth (feet) 105
 - (3) static water level (feet) 65 below above top of ground.
 - (4) casing PVC 95'
(material) (depth)
4" if telescope see back.
(size)
 - (5) screen 10' 95'
(length) (depth to top)
.010 PVC
(size) (material)
 - (6) pump did not install
(HP) (yield gpm)
(type power)
 - (7) electric log no
(yes or no)
(organization running log)

(8) how well bottom plugged
back wash valve

DRILLERS REMARKS:


DEPT. OF NATURAL RESOURCES
BUREAU OF LAND & WATER RESOURCES

AUG 30 1983

RECEIVED

If well telescopes please sketch and show depths.

GROUND LEVEL

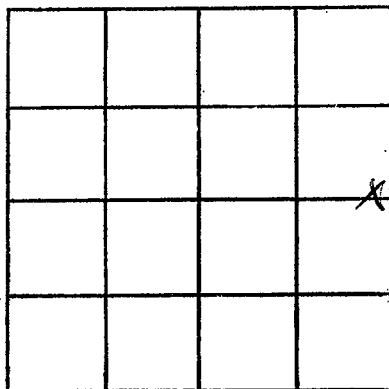

SECTION 6

Please indicate well location X.

ADDITIONAL INFORMATION

If more than one screen,
show locations of each on sketch.