

Lincoln
H
2045

MISSISSIPPI DEPARTMENT OF NATURAL RESOURCES
Bureau of Land and Water Resources
Southport Mall
P.O. Box 10631
Jackson, Mississippi 39209
WATER WELL DRILLERS LOG

June 25 1984 Grenn Water Well Lincoln
date well completed firm name county well located

LANDOWNER: Charles Marcee
154 Cedar St.
Brookhaven, Ms.
(mailing address)

description of formations encountered	from	to
Citronelle	1	83

WELL LOCATION:
sec. 8 T 7 N R 8 E
S W
1/4 miles W of Brookhaven
(distance) (direction) (nearest town)

WELL PURPOSE: home
(home, irrigation, municipal, industrial)

WELL COMPLETION DATA:

(1) diameter (inches) 4

(2) total depth (feet) 83

(3) static water level (feet) 48 below above top of ground.

(4) casing PVC 73' (material) (depth), 4" (size) if telescope see back.

(5) screen 10' 73' (length) (depth to top), .010 PVC (size) (material)

(6) pump 1/2 sub 8 (HP) (yield gpm)
electricity (type power)

(7) electric log no (yes or no)
(organization running log)

(8) how well bottom plugged back wash valve

DRILLERS REMARKS:


DEPT. OF NATURAL RESOURCES
BUREAU OF LAND & WATER RESOURCES

SEP 18 1984

RECEIVED

If well telescopes please sketch and show depths.

GROUND LEVEL

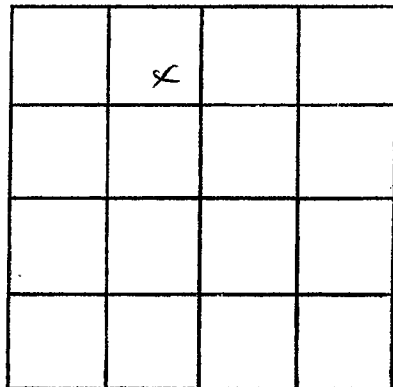

SECTION 8

Please indicate well location X.

ADDITIONAL INFORMATION

If more than one screen,
show locations of each on sketch.