

MISSISSIPPI DEPARTMENT OF NATURAL RESOURCES

Bureau of Land and Water Resources

Southport Mall

P.O. Box 10631

Jackson, Mississippi 39209

WATER WELL DRILLERS LOG

Lincoln
H
2049

2-15
 date well completed

1985 F. Lyubal Well Serv
 firm name

Lincoln
 county well located

LANDOWNER:	description of formations encountered	from	to
<u>Bice Miller</u>	<u>Red clay</u>	<u>0</u>	<u>20</u>
<u>P.R. Brockton Mrs.</u> (mailing address)	<u>Red sandstone</u>	<u>20</u>	<u>50</u>
WELL LOCATION: sec. <u>30</u> T <u>2</u> N R <u>8</u> E S W <u>2</u> miles <u>S</u> of <u>Brockton</u> (distance) (direction) (nearest town)	<u>white chalk</u>	<u>50</u>	<u>140</u>
WELL PURPOSE: <u>Home</u> (home, irrigation, municipal, industrial)	<u>Coarse sandstone</u>	<u>140</u>	<u>155</u>
WELL COMPLETION DATA:			
(1) diameter (inches) <u>4</u>			
(2) total depth (feet) <u>155</u>			
(3) static water level (feet) <u>60</u> below above top of ground.			
(4) casing <u>4" PVC</u> , <u>145</u> , (material) (depth)			
<u>4</u> if telescope see back. (size)			
(5) screen <u>10</u> , <u>145</u> (length) (depth to top)			
<u>4</u> , <u>PVC</u> (size) (material)			
(6) pump <u>1/2</u> , <u>10</u> (HP) (yield gpm)			
<u>Electric</u> (type power)			
(7) electric log <u>No</u> (yes or no)			
(organization running log)			
(8) how well bottom plugged <u>Sandstone</u>			

RECEIVED


MAR 5 - 1985

DRILLERS REMARKS:

Department of Natural Resources
 Bureau of Land & Water Resources

If well telescopes please sketch and show depths.

GROUND LEVEL

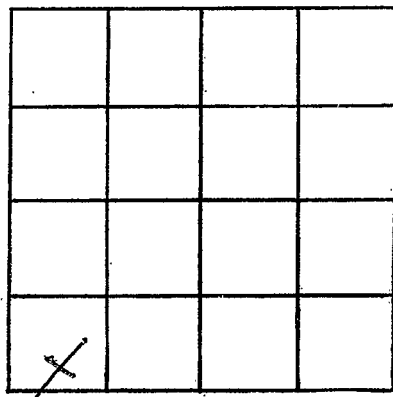

SECTION 30

Please indicate well location X.

ADDITIONAL INFORMATION

If more than one screen,
show locations of each on sketch.