

**MISSISSIPPI DEPARTMENT OF NATURAL RESOURCES**  
**Bureau of Land and Water Resources**  
 Southport Mall  
 P.O. Box 10631  
 Jackson, Mississippi 39209  
**WATER WELL DRILLERS LOG**

LINCOLN
H
2050

7-17      19 85      Grenn Water Well      Lincoln  
 date well completed      firm name      county well located

**LANDOWNER:** Doug Grissom  
 110 Lake Shore Drive  
 Brookhaven, Ms.  
 (mailing address)

description of formations encountered	from	to
Citronelle	1	103

**WELL LOCATION:**  
 sec. 30 T 7 N R 8 E  
                   S                  W  
 2 miles south of Brookhaven  
 (distance) (direction) (nearest town)

**WELL PURPOSE:** home  
 (home, irrigation, municipal, industrial)

**WELL COMPLETION DATA:**

(1) diameter (inches) 4

(2) total depth (feet) 113

(3) static water level (feet) 37 below above top of ground.

(4) casing PVC, 103  
 (material) (depth)  
 4" if telescope see back.  
 (size)

(5) screen 10' , 103'  
 (length) (depth to top)  
 .010 PVC  
 (size) (material)

(6) pump 1/2 sub 7  
 (HP) (yield gpm)  
 electricity  
 (type power)

(7) electric log n0  
 (yes or no)  
 (organization running log)

(8) how well bottom plugged back wash valve


**DRILLERS REMARKS:**

**RECEIVED**  
 AUG 13 1985

Department of Natural Resources  
 Bureau of Land & Water Resources

If well telescopes please  
sketch and show depths.

GROUND LEVEL

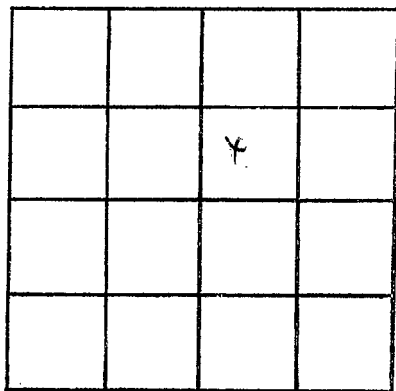

SECTION 30

Please indicate well location X.

ADDITIONAL INFORMATION

If more than one screen,  
show locations of each on sketch.