

MISSISSIPPI DEPARTMENT OF NATURAL RESOURCES

Bureau of Land and Water Resources

Southport Mall

P.O. Box 10631

Jackson, Mississippi 39209

WATER WELL DRILLERS LOG

Lincoln
253

Oct. 9	19 85	Grenn Water Well	Lincoln
date well completed		firm name	county well located

LANDOWNER: <u>Bobbie J. Price</u>	description of formations encountered	from	to
<u>Rt. 5. Box 508</u>			
<u>Brookhaven, Ms.</u> (mailing address)	<u>Citronelle</u>	<u>1</u>	<u>150</u>
WELL LOCATION:			
sec. <u>17</u> T. <u>7</u> N. R. <u>8</u> E S W			
<u>1/2</u> miles <u>East</u> of <u>Brookhaven</u> (distance) (direction) (nearest town)			
WELL PURPOSE: <u>home</u> (home, irrigation, municipal, industrial)			
WELL COMPLETION DATA:			
(1) diameter (inches) <u>4</u>			
(2) total depth (feet) <u>150</u>			
(3) static water level (feet) <u>42</u> below top of ground.			
(4) casing <u>PVC</u> <u>140</u> (material) (depth) <u>4"</u> (size) if telescope see back.			
(5) screen <u>10'</u> <u>140'</u> (length) (depth to top) <u>.010</u> <u>PVC</u> (size) (material)			
(6) pump <u>1/2</u> sub <u>8</u> (HP) (yield gpm) <u>electricity</u> (type power)			
(7) electric log <u>no</u> (yes or no) (organization running log)			
(8) how well bottom plugged: <u>back wash valve</u>			


RECEIVED
NOV - 4 1985

DRILLERS REMARKS: _____

Department of Natural Resources
Bureau of Land & Water Resources

If well telescopes please sketch and show depths.

GROUND LEVEL

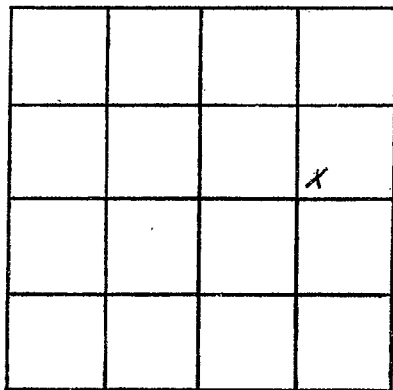

SECTION 17

Please indicate well location X.

ADDITIONAL INFORMATION

If more than one screen,
show locations of each on sketch.