

MISSISSIPPI DEPARTMENT OF NATURAL RESOURCES

Bureau of Land and Water Resources

Southport Mall

P.O. Box 10631

Jackson, Mississippi 39209

WATER WELL DRILLERS LOG

Lincoln
H 2054

10-15

1985

Gretn Water Well

Lincoln

date well completed

firm name

county well located

LANDOWNER: Brenda King

P.O. Box 3155

Brookhaven, Ms.

(mailing address)

WELL LOCATION:

sec. 34 T 7 N R 8 E
S W
3 miles SE of Brookhaven
(distance) (direction) (nearest town)

WELL PURPOSE: Home
(home, irrigation, municipal, industrial)

WELL COMPLETION DATA:

- (1) diameter (inches) 4
- (2) total depth (feet) 53
- (3) static water level (feet) 26' below top of ground.
- (4) casing PVC 43' (material) (depth)
4" (size) if telescope see back.
- (5) screen 10' 43' (length) (depth to top)
0.010 PVC (size) (material)
- (6) pump 1/2 sub 8 (HP) (yield gpm)
electricity (type power)
- (7) electric log no (yes or no)

(organization running log)


(8) how well bottom plugged back wash valve

DRILLERS REMARKS:

description of formations encountered

from	to
1	20
20	53

Clay
Sand

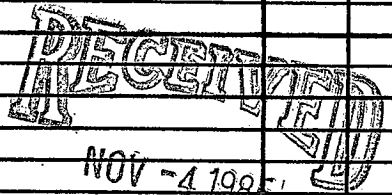

Department of Natural Resources
Bureau of Land & Water Resources

If well telescopes please sketch and show depths.

GROUND LEVEL

X			

SECTION 34

Please indicate well location X.

ADDITIONAL INFORMATION

If more than one screen,
show locations of each on sketch.