

MISSISSIPPI DEPARTMENT OF NATURAL RESOURCES

Bureau of Land and Water Resources

P.O. Box 10631

Jackson, Mississippi 39209

WATER WELL DRILLERS LOG

COUNTY WELL LOCATED <i>Lincoln</i>	
WELL NUMBER <i>H 2065</i>	CODED
DATE WELL COMPLETED <i>10-26-88</i>	

PERMIT NUMBER
NAME OF DRILLING FIRM <i>Green Water Well & Supply, Inc.</i>

NAME & MAILING ADDRESS OF LANDOWNER <i>Joe Stewart</i>		
<i>525 E. Gate Drive</i>		
<i>Brookhaven, Miss</i>		
WELL LOCATION: SEC	TOWNSHIP	RANGE
<i>21</i>	<i>7</i>	<i>8</i>
<input checked="" type="radio"/> N <input checked="" type="radio"/> E <input type="radio"/> S <input type="radio"/> W		
DISTANCE	DIRECTION	NEAREST TOWN
<i>2</i> Miles	<i>E</i>	<i>of Brookhaven</i>
OTHER LANDMARK		
WELL PURPOSE: Home, Irrigation, Municipal, Industrial, Fish Pond, etc. <i>Gift Shop</i>		

PUMP DATA		
PUMP TYPE (Circle One): <input checked="" type="radio"/> Submersible, Turbine, Jet Flowing Well, Other (Describe) _____		
POWER TYPE (Circle One): <input checked="" type="radio"/> Electric, Tractor, Diesel, Gasoline, Butane, Other (Describe) _____ H/P <i>1/2</i>		
Pump Capacity (GPM) <i>10</i>	No. of Stages <i>10</i>	Setting Depth <i>61</i> FT.
PUMP TEST		
Well yielded <i>14</i> GPM with a drawdown of <i>0</i> ft. after <i>2</i> hours of pumping		

WELL DATA		
Well Depth <i>65</i>	Casing Diameter (In.) <i>4</i>	Casing Length (Ft.) <i>55</i>
Type of Casing <i>PVC</i>	Hole Depth <i>70</i>	Depth to Static Water Level <i>43</i>
TYPE OF COMPLETION: (Circle One or More): <input checked="" type="radio"/> Gravel Packed, Underreamed, Telescoped, Natural Development, Open Hole, Other (Describe) _____		
Top of Lap Pipe or Reduction in Casing		
FEET IF TELESCOPED OR MORE THAN ONE SCREEN: USE BACK PAGE		

LOG DATA	
TYPE OF LOG RUN (Circle One): Electric, Gamma Ray, Density, <input checked="" type="radio"/> Sonic, Neutron, Other (Describe) _____	
Name of Organization Running Log	

SCREEN DATA		
Diameter - Inches <i>4</i>	Length - Feet <i>10</i>	Slot Size - Inches <i>.010</i>
Screen Type <i>PVC</i>		Depth to Bottom - Feet <i>65</i>

GEOLOGIC DATA (Office Use Only)			
Surface Elev.	Geologic Unit	Unit Thickness	Depth to Top
Subs. SWL	Date	Analysis	Aquifer Test


Driller's Remarks

DESCRIPTION OF FORMATIONS ENCOUNTERED	FROM	TO	FORMATIONS (Continued)	FROM	TO
<i>Citronelle</i>	<i>0</i>	<i>70</i>	<div style="font-size: 2em; font-weight: bold; opacity: 0.5;">RECEIVED</div> <div style="font-size: 1.5em; font-weight: bold; margin-top: 10px;">FEB 15 1989</div> <div style="font-size: 0.8em; font-weight: bold; margin-top: 10px;">Department of Natural Resources Bureau of Land & Water Resources</div>		

IF MORE SPACE IS NEEDED, USE BACK

If well telescopes please
sketch and show depths.

GROUND LEVEL

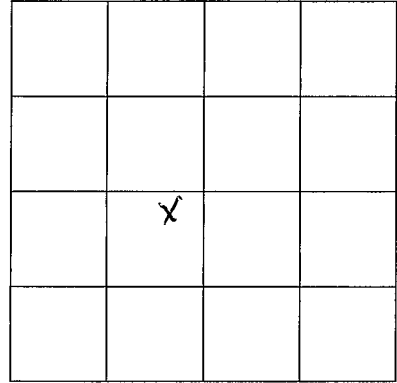

SECTION 21

Please indicate well location X.

ADDITIONAL INFORMATION

If more than one screen,
show location of each on sketch.