

**MISSISSIPPI DEPARTMENT OF NATURAL RESOURCES**

Bureau of Land and Water Resources

P.O. Box 10631

Jackson, Mississippi 39209

**WATER WELL DRILLERS LOG**

COUNTY WELL LOCATED <b>Lincoln</b>	
WELL NUMBER <b>330469</b>	CODED
<b>H 2081</b>	
DATE WELL COMPLETED <b>1-16-92</b>	

PERMIT NUMBER <b>510</b>
NAME OF DRILLING FIRM <b>EASLEY WATER Well</b>
<b>BROOKHAVEN, MS 39601</b>

NAME & MAILING ADDRESS OF LANDOWNER <b>Billy NATIONS</b>			
WELL LOCATION:	SEC	TOWNSHIP	RANGE
	<b>19</b>	<b>7</b>	<b>8</b>
		<b>N</b>	<b>W</b>
		<b>S</b>	
DISTANCE	DIRECTION	NEAREST TOWN	
<b>2</b> Miles	<b>S</b>	of <b>Brookhaven</b>	
OTHER LANDMARK			
WELL PURPOSE: Home, Irrigation, Municipal, Industrial, Fish Pond, etc. <b>Home</b>			

<b>PUMP DATA</b>		
PUMP TYPE (Circle One): Submersible, Turbine, Jet, Flowing Well, Other (Describe) <b>NONE</b>		
POWER TYPE (Circle One): Electric, Tractor, Diesel, Gasoline, Butane, Other (Describe)		
Pump Capacity (GPM)	No. of Stages	Setting Depth:  <b>FT.</b>
PUMP TEST		
Well yielded _____ GPM with a drawdown of _____ ft. after _____ hours of pumping		

<b>WELL DATA</b>		
Well Depth <b>70'</b>	Casing Diameter (In.) <b>4"</b>	Casing Length (Ft.) <b>50'</b>
Type of Casing <b>Pvc</b>	Hole Depth <b>70'</b>	Depth to Static Water Level
TYPE OF COMPLETION: (Circle One or More): Gravel Packed, Underreamed, Telescoped, Natural Development, Open Hole, Other (Describe)		
Top of Lap Pipe or Reduction in Casing  <b>FEET</b> IF TELESCOPED OR MORE THAN ONE SCREEN: USE BACK PAGE		

<b>LOG DATA</b>	
TYPE OF LOG RUN (Circle One): <b>No Log Run</b> Electric, Gamma Ray, Density, Sonic, Neutron, Other (Describe)	
Name of Organization Running Log	

<b>SCREEN DATA</b>		
Diameter - Inches <b>4"</b>	Length - Feet <b>20'</b>	Slot Size - Inches <b>012</b>
Screen Type <b>Pvc</b>	Depth to Bottom - Feet	


<b>GEOLOGIC DATA (Office Use Only)</b>			
Surface Elev.	Geologic Unit	Unit Thickness	Depth to Top
Subs. SWL	Date	Analysis	Aquifer Test
Driller's Remarks			

DESCRIPTION OF FORMATIONS ENCOUNTERED	FROM	TO	FORMATIONS (Continued)	FROM	TO
<b>CLAY</b>	<b>0'</b>	<b>10'</b>	<b>RECEIVED</b>  <b>JUN 26 1992</b>  <b>Dept. of Environmental Quality Bureau of Land &amp; Water Resources</b>		
<b>SAND</b>	<b>10'</b>	<b>30'</b>			
<b>COARSE SAND</b>	<b>30'</b>	<b>50'</b>			
<b>CLAY</b>	<b>50'</b>	<b>70'</b>			

IF MORE SPACE IS NEEDED, USE BACK

If well telescopes please  
sketch and show depths.

GROUND LEVEL

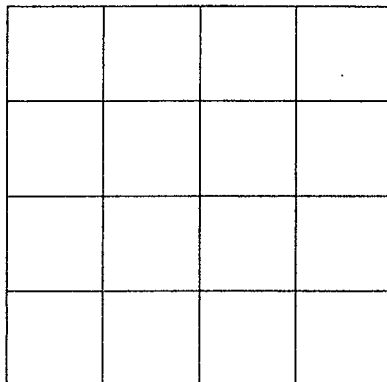

SECTION \_\_\_\_\_

Please indicate well location X.

ADDITIONAL INFORMATION

If more than one screen,  
show location of each on sketch.